

PLAT OF SURVEY OF the North 40 feet of Lot 2 in Lost Nation Park Subdivision, located in Section 14, T4N R16E,
Walworth County, Wisconsin.

I, Thomas P. A. Jensen, do hereby certify that I have surveyed the above described property and that the plot
shown herein is an accurate survey and a true representation thereof and correctly shows the boundary lines of
said property and all buildings thereon.


June 29, 1977

Thomas P. A. Jensen

Thomas P.A. S-1084

JENSEN SURVEYING & MAPPING, ELKHORN, WISCONSIN

SBG-116 174.15'

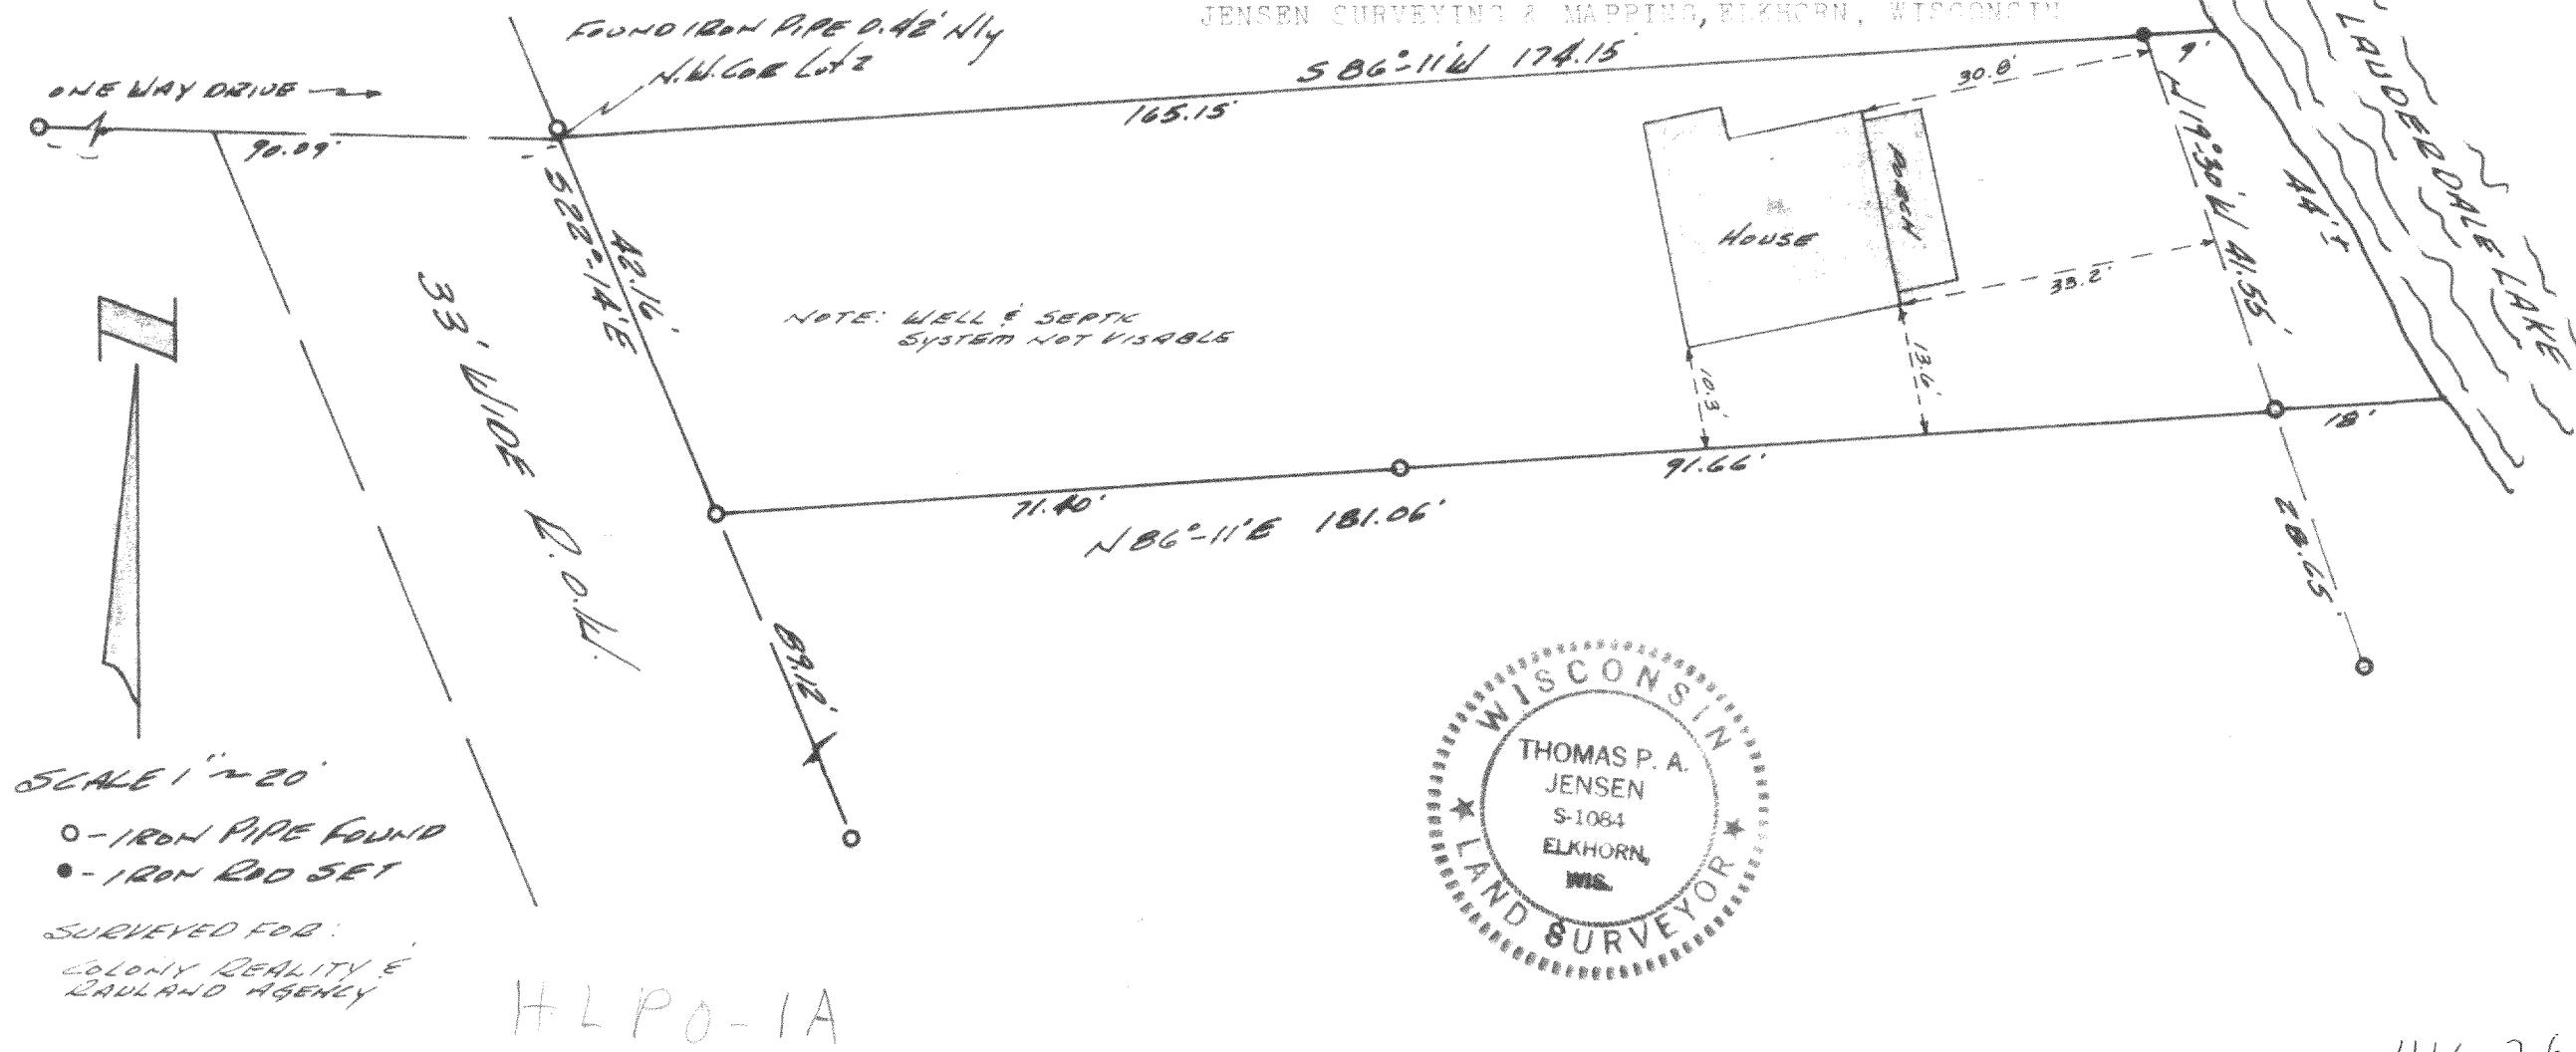

PLAT OF SURVEY OF the North 40 feet of Lot 2 in Lost Nation Park Subdivision, located in Section 35, T4N R16E,
Walworth County, Wisconsin.

I, Thomas P. A. Jensen, do hereby certify that I have surveyed the above described property and that the plat
shown hereon is an accurate survey and a true representation thereof and correctly shows the boundary lines of
said property and all buildings thereon.



June 29, 1977

Thomas P. A. Jensen

Thomas P. A. Jensen S-1084

JENSEN SURVEYING & MAPPING, ELKHORN, WISCONSIN

SOG-114 174.15'

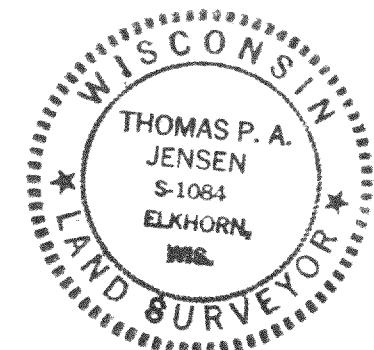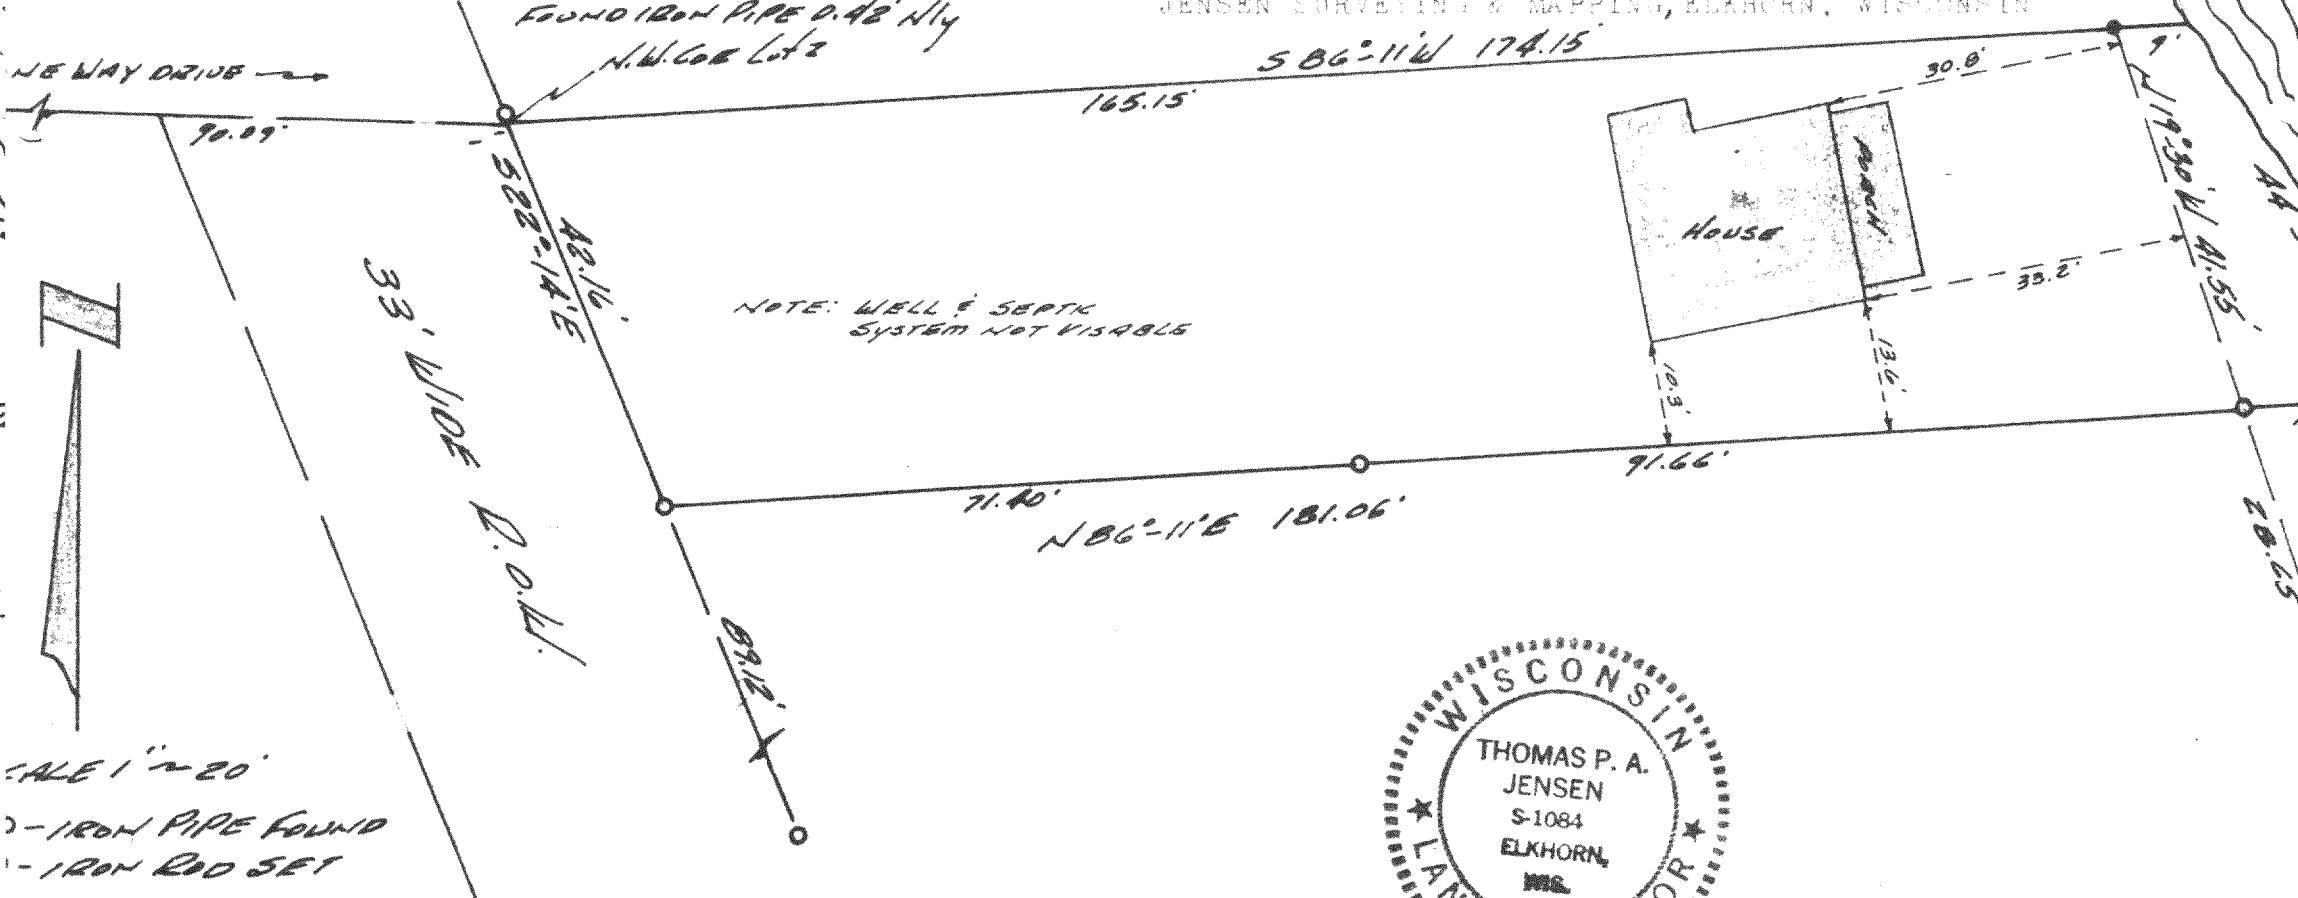

H L P O - 1A