
## LAND-MARK SURVEYING Mark L. Miritz

Wisconsin Registered Land Surveyor S-2582

N9330 Knuteson Drive Whitewater, WI 53190 Phone:(262)495-3284 MARKMIRITZ@ LAND-MARKSURVEYING.COM

## PLAT OF SURVEY

LOT 3, MERRILL PARK SUBDIVISION, LOCATED IN THE SOUTHWEST 1/4 OF SECTION 26, TOWN 4 NORTH, RANGE 16 EAST, LAGRANGE TOWNSHIP, WALWORTH COUNTY, WISCONSIN.

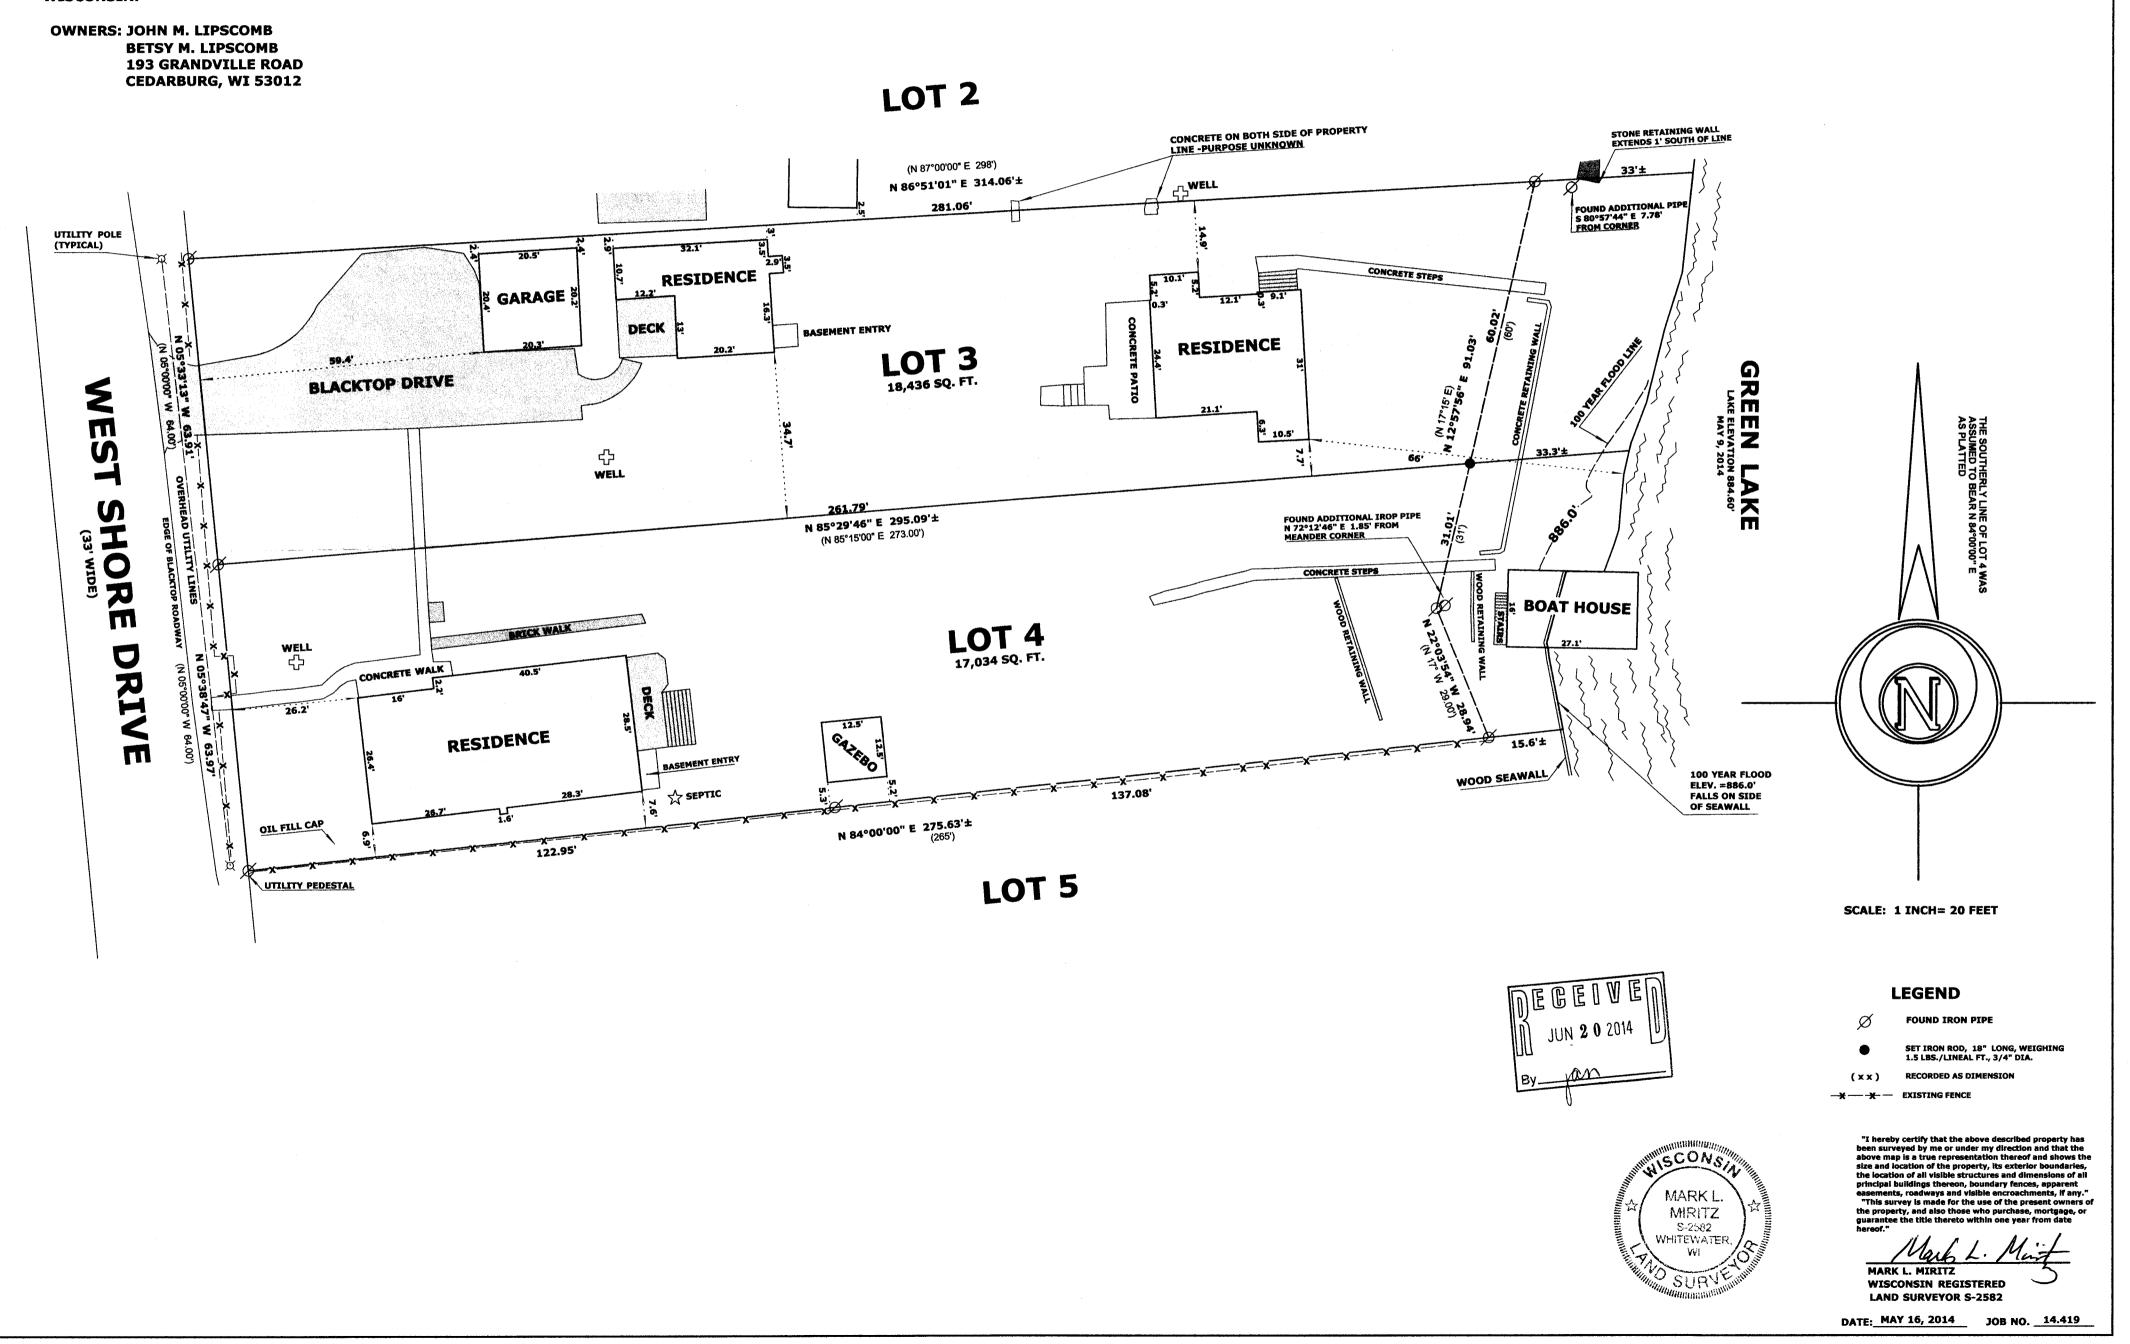

HME-3