

AMBIT LAND SURVEYING  
P. O. Box 42  
Bassett, Wisconsin 53101  
Licensed Professionals in  
both Illinois & Wisconsin

# PLAT OF SURVEY OF



PHONE: 262-537-4874

FAX: 262-537-4221

EMAIL: ambit@tds.net

Lot 16, Block 2 of PEBBLE BEACH, a subdivision located in the Northeast Quarter of the Northeast Quarter of Section 26 and the Northwest Quarter and the Northeast Quarter of the Northwest Quarter of Section 25, Township 4 North, Range 16 East of the 4th Principal, Town of La Grange, Walworth County, Wisconsin.

PARCEL IDENTIFICATION NO.: HPE 00039

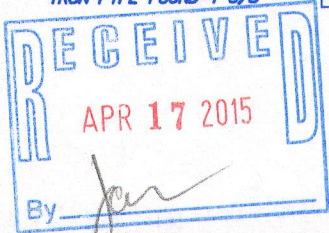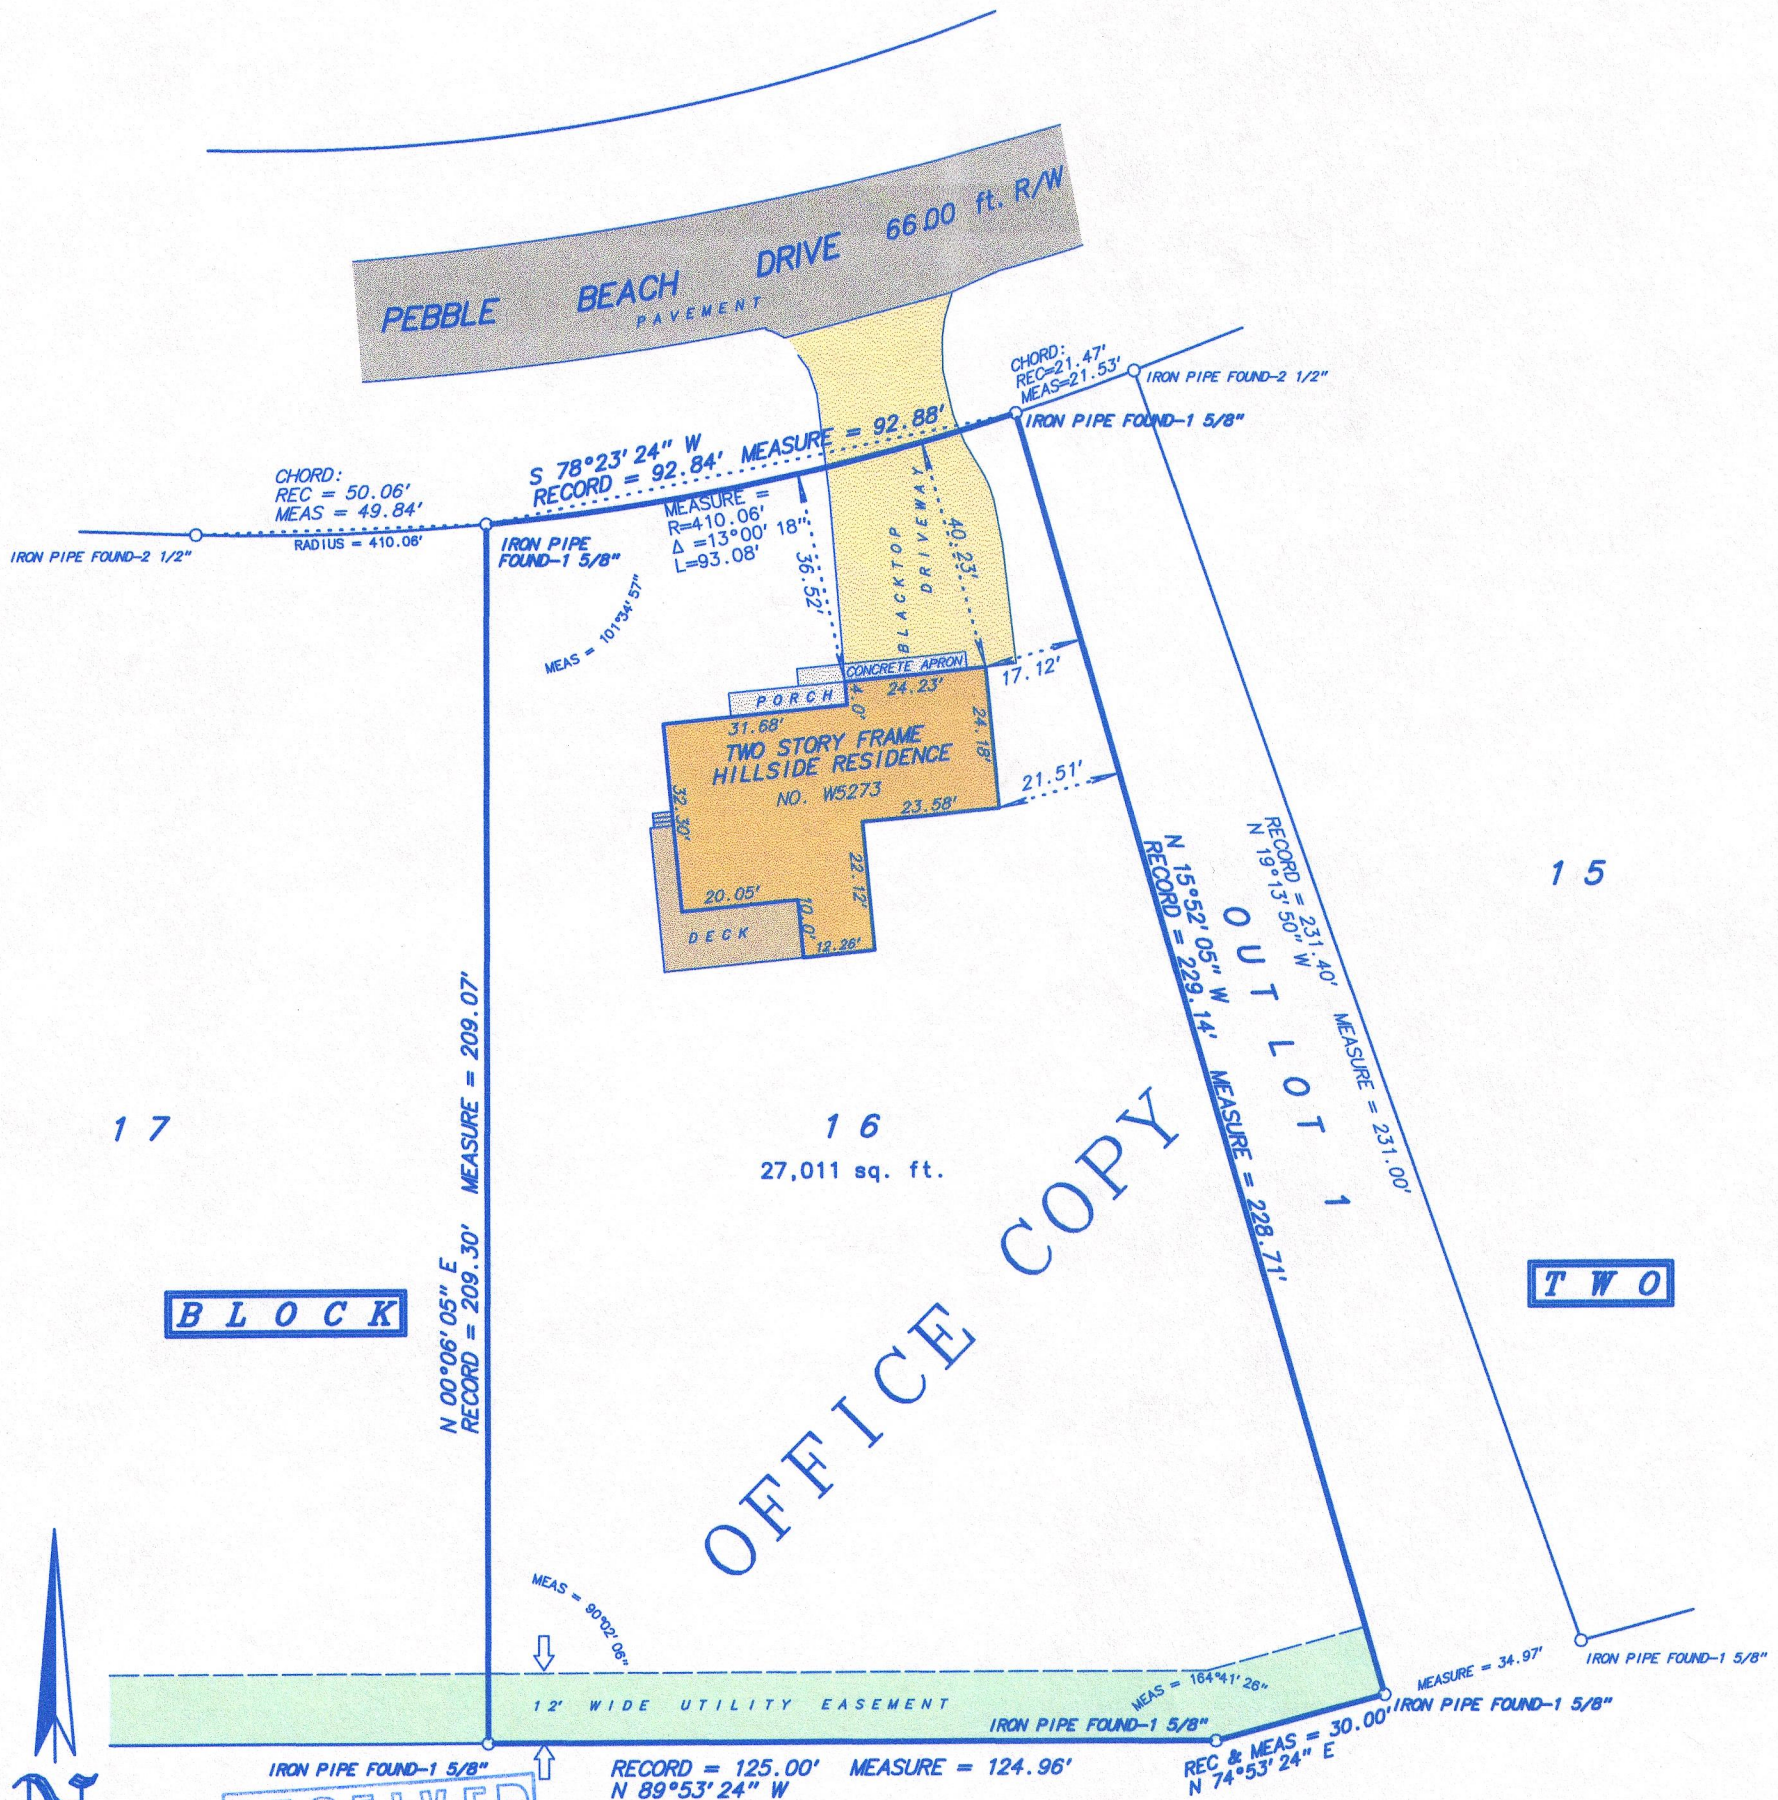

OUT LOT 1

Fieldwork completed on and date of certification: September 9, 2013

I hereby certify that I have surveyed the above described property and the above plat is a true representation thereof and shows the size and location of the property, its exterior boundaries, the location and dimensions of all visible structures thereon, boundary fences, apparent easements and roadways and visible encroachments, if any.

This survey is made for the exclusive use of the present owners of the property, and also those who purchase, mortgage or guarantee the title thereto within ONE YEAR from the date hereof.

Dated at Bassett, Wisconsin this \_\_\_\_\_ day of \_\_\_\_\_ 2013.

Mark A. Bolender

Mark A. Bolender  
Wisconsin Professional Land Surveyor 1784

SCALE: NOT TO SCALE  
1 inch = 30 feet

ORDERED BY: D. Schiltz / Schiltz Law Office

JOB NO.: 13105

HPE -39

416-2768