PREPARED FOR LAURIE BOVIALL REALTY EXECUTIVES

JOB # 16-11

TAX ID # HCH 00027

## PLAT OF SURVEY

This survey is made for the present owners of the property, and those who

DATED THIS 21st DAY OF JANUARY, 2016.

purchase, mortgage, or guarantee the title thereto, within one year from

the date hereof.

- OF -

LOT 8, BLOCK 4 COOL HILL PARK, A SUBDIVISION LOCATED IN THE NW 1/4 AND SW 1/4 OF SECTION 35, TOWN 4 NORTH, RANGE 16 EAST, TOWN OF LAGRANGE, COUNTY OF WALWORTH AND STATE OF WISCONSIN.

PATHFINDER SURVEYING INC.


(formerly)

J.K. SURVEYING INC.

P.O BOX 322

LAKE GENEVA, WI. 53147

WWW.PATHFINDERSURVEYING.NET
262-248-8303

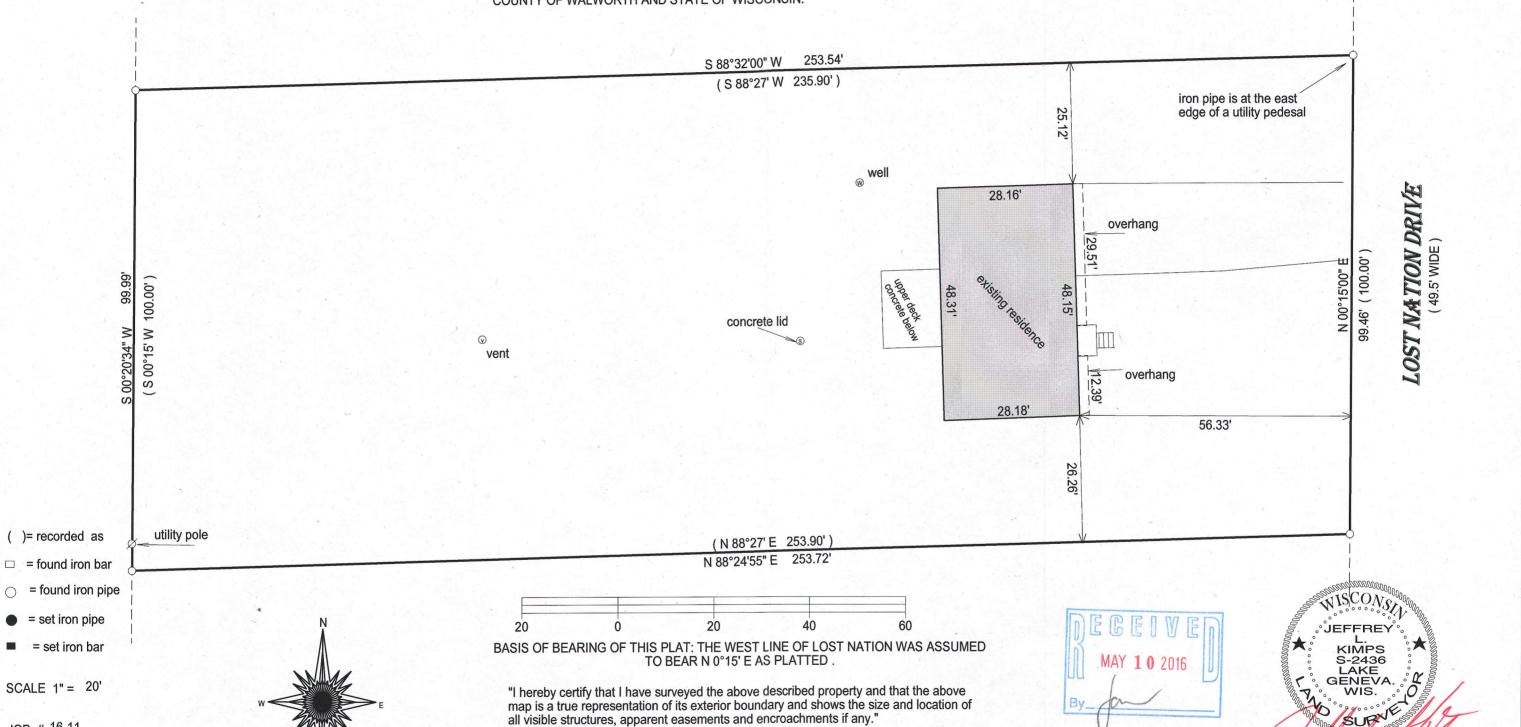

JEFFREY L KIMPS S 2436 Wisconsin Professional Land Surveyor ( original if signed in red )