## LAND-MARK SURVEYING

Mark L. Miritz Wisconsin Professional Land Surveyor S-2582

N9330 Knuteson Drive Whitewater, WI 53190 Phone:(262)495-3284 MARKMIRITZ@ LAND-MARKSURVEYING.COM

PLAT OF SURVEY


**LEGAL DESCRIPTION:** 

**LOT 113, MARINER HILLS SUBDIVISON** 

LOCATED IN THE NORTHWEST 1/4 OF THE SW 1/4, SECTION 34, TOWNSHIP 4 NORTH, RANGE 16 EAST, IN THE TOWN OF LAGRANGE, **WALWORTH CO., WISCONSIN** 

**ORDERED BY:** KANCHANA HAMILTON SHOREWEST REALTY 839 E. GENEVA STREET **DELAVAN, WI 53115** 

OWNER: **PETER RIZZO** 7358 W. BREEN ST. NILES, IL. 60714

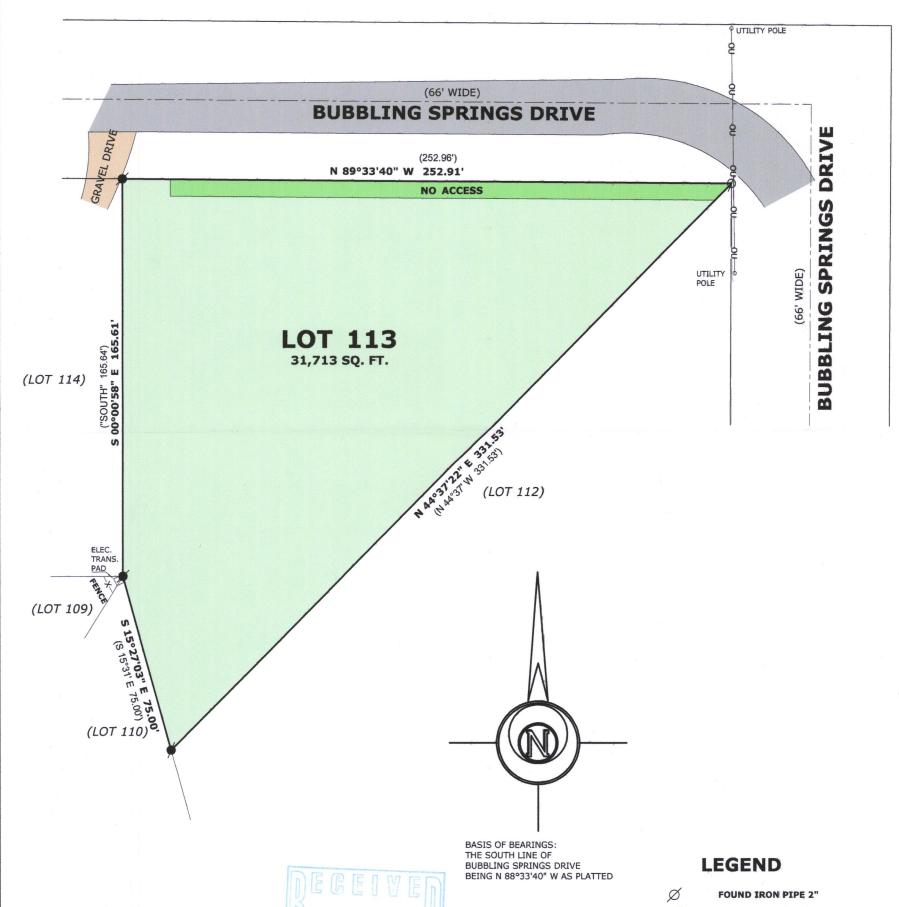



HMH-113

JUL 3 1 2017

416-2930

FOUND IRON ROD 3/4"

RECORDED AS DIMENSION

## SCALE: 1 INCH = 40 FEET

"I hereby certify that the above described property has been surveyed by me or under my direction and that the above map is a true representation thereof and shows the size and location of the property, its exterior boundaries, the location of all visible structures and dimensions of all principal buildings thereon, boundary fences, apparent easements, roadways and visible encroachments, if any."

"This survey is made for the use of the present owners of the

the property, and also those who purchase, mortgage, or guarantee the title thereto within one year from date hereof."

MARK L. MIRITZ WISCONSIN PROFESSIONAL **LAND SURVEYOR S-2582** 

DATE: April 22, 2017

JOB NO. \_17.406