LAND-MARK SURVEYING Mark L. Miritz

Wisconsin Professional Land Surveyor S-2582

N9330 Knuteson Drive Whitewater, WI 53190 Phone:(262)495-3284 MARKMIRITZ@ LAND-MARKSURVEYING.COM


PLAT OF SURVEY

LOT 97 OF THE 2ND ADDITION TO BUBBLING SPRINGS SUBDIVISION, LOCATED IN THE SOUTHEAST 1/4 OF SECTION 34, TOWN 4 NORTH, RANGE 16 EAST, LAGRANGE TOWNSHIP, WALWORTH COUNTY, WISCONSIN.

ORDERED BY: KANCHANA HAMILTON SHOREWEST REALTY 839 E. GENEVA STREET DELAVAN, WI 53115

OWNER: PETER RIZZO 7358 W. BREEN ST. NILES, IL. 60714

OUTLOT "B"

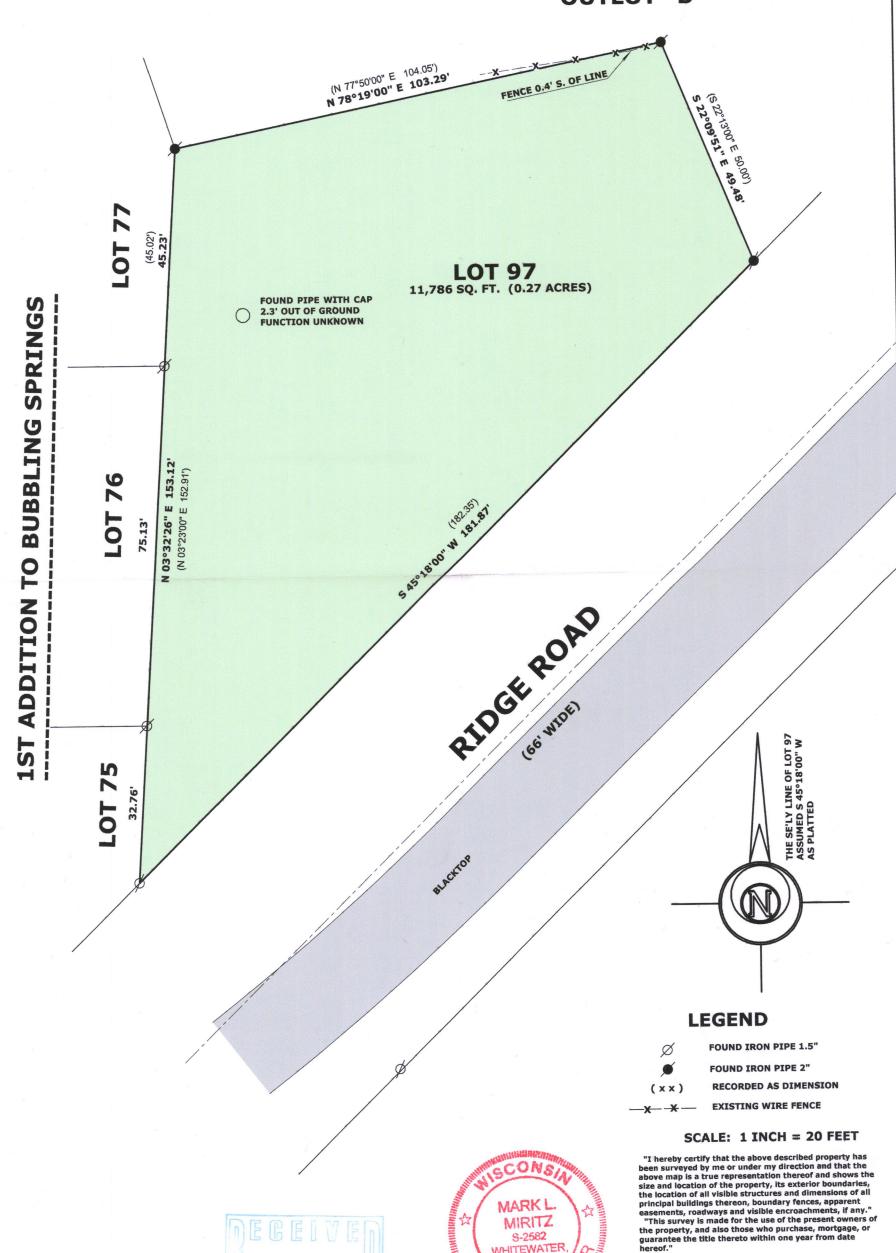

9-2582 WHITEWATER

SUR

416-2931

JUL 3 1 2017

HB82-18

MARK L. MIRITZ WISCONSIN PROFESSIONAL **LAND SURVEYOR S-2582**

DATE: APRIL 22, 2017

JOB NO. 17.408