
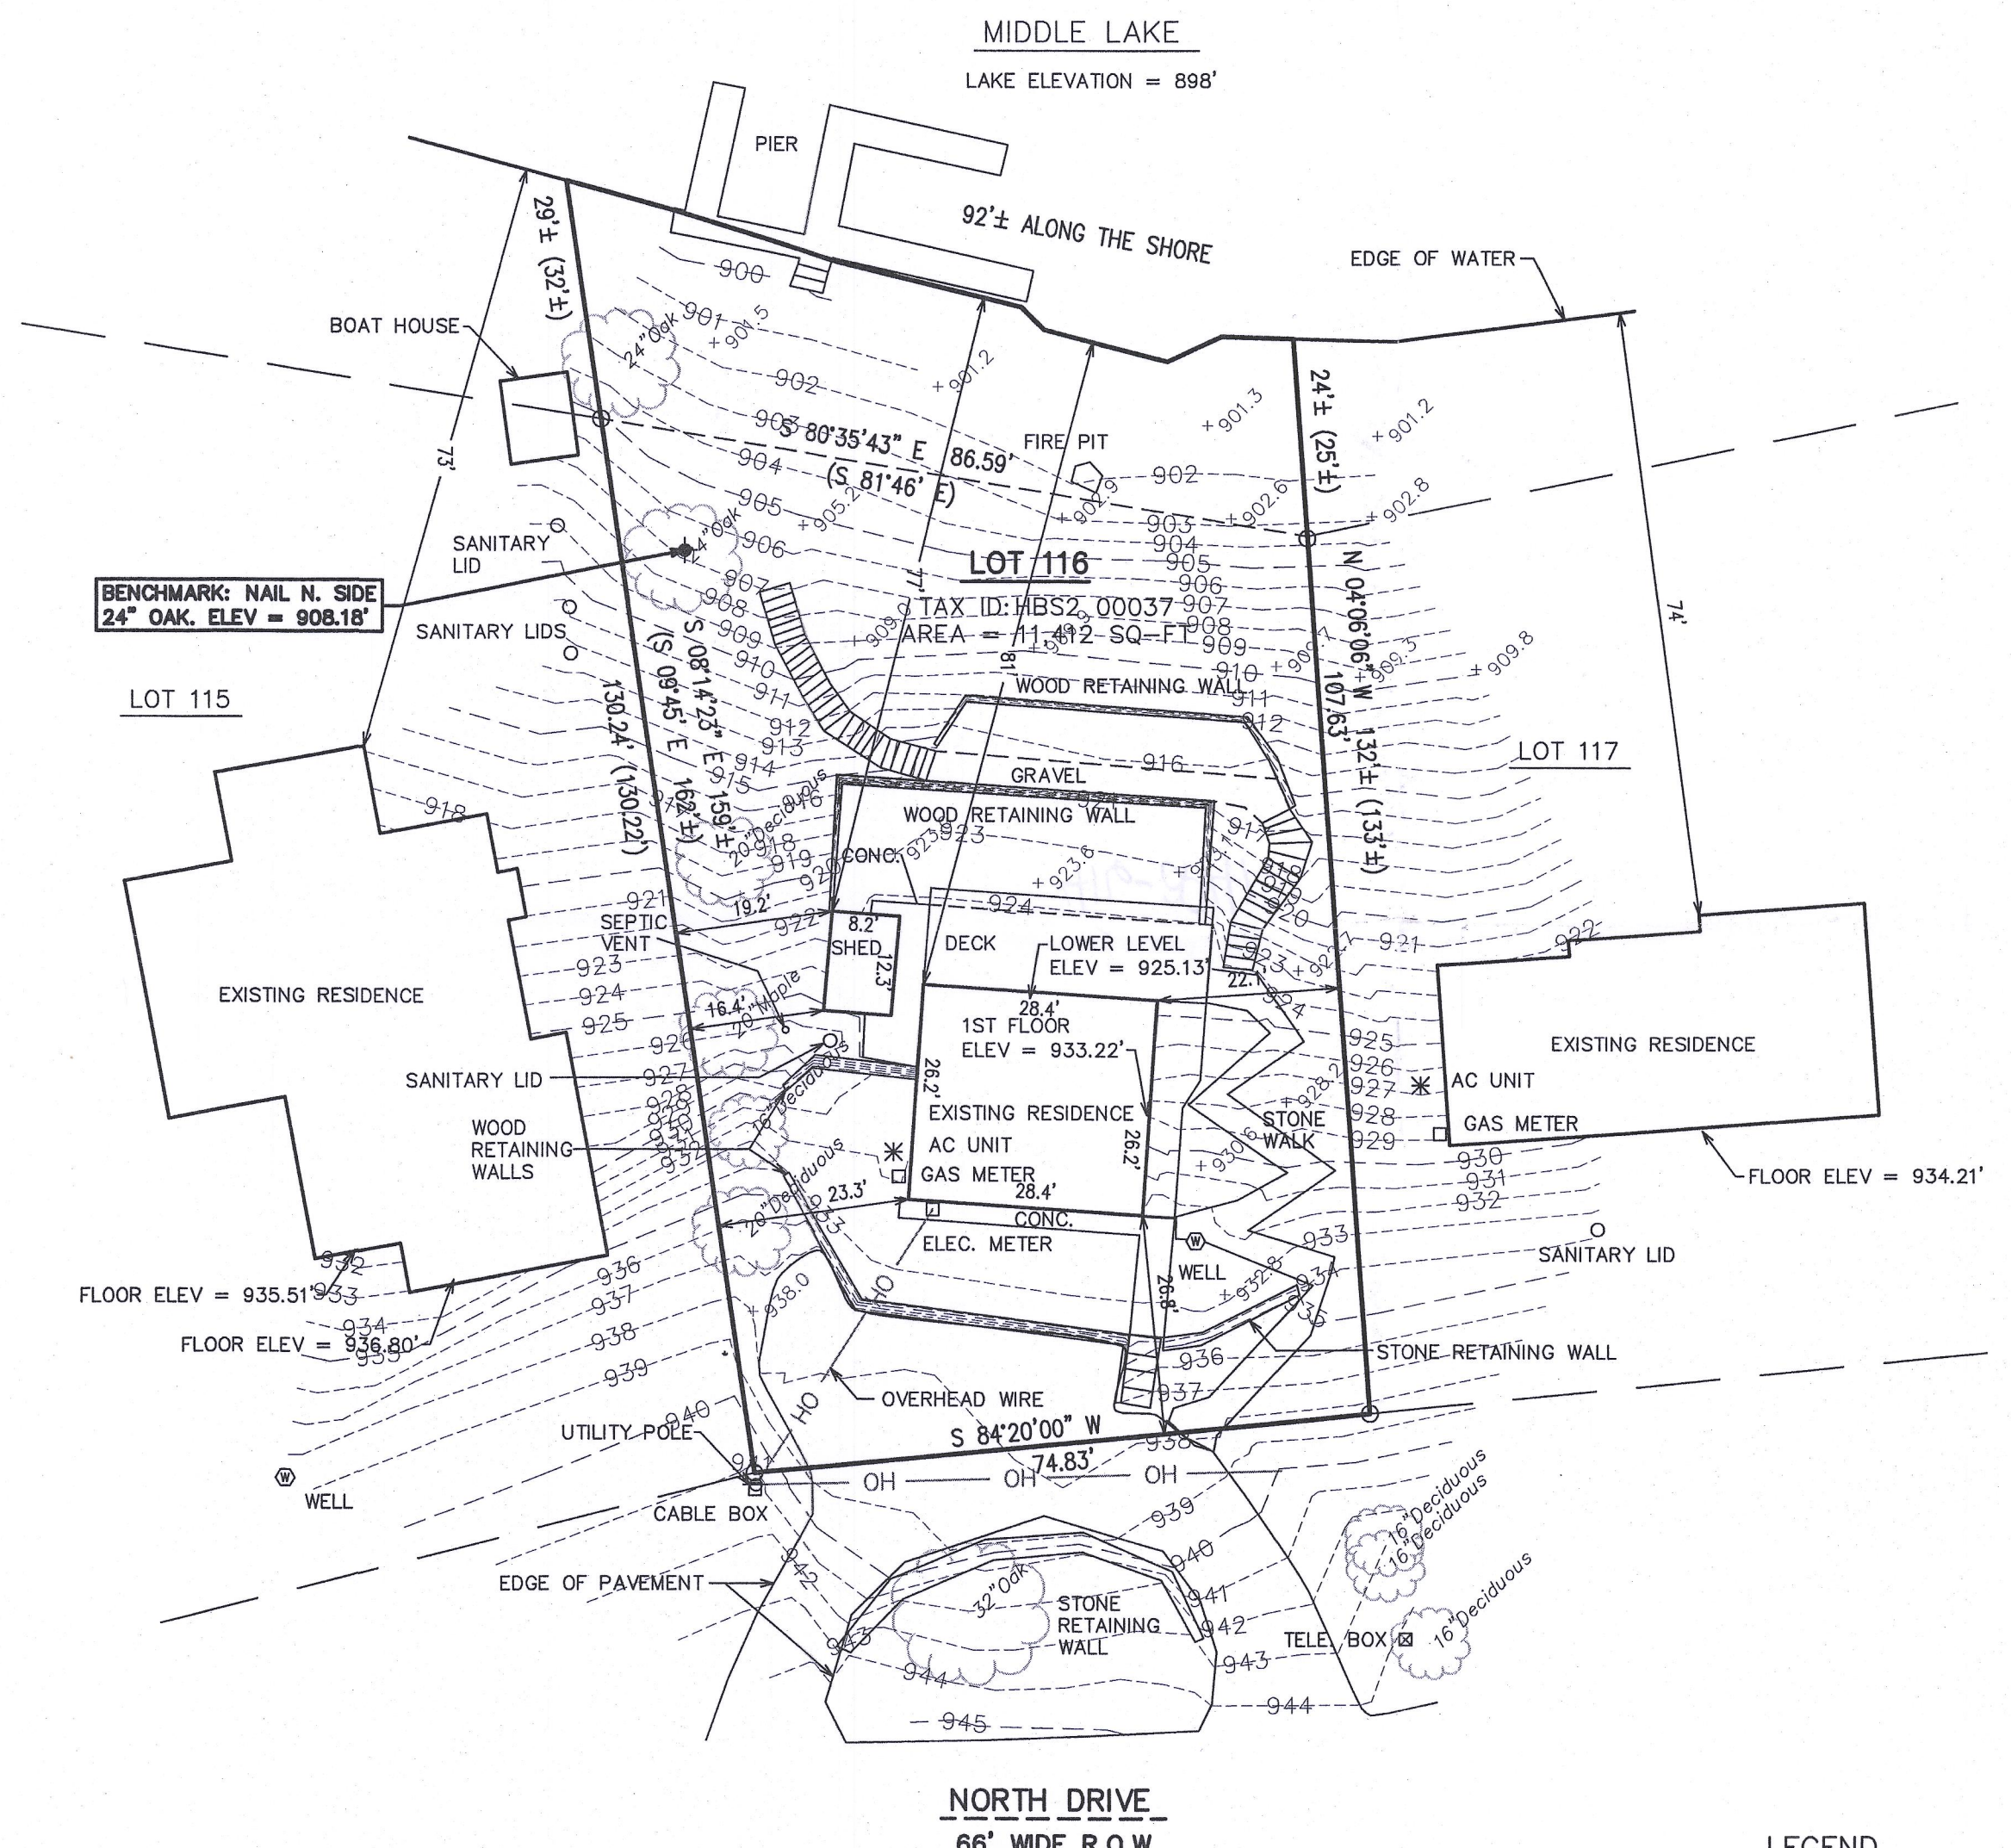



# BOUNDARY AND TOPOGRAPHIC SURVEY LOT 116 2ND ADDITION TO BUBBLING SPRINGS SUBDIVISION

LOCATED IN THE SE 1/4 OF THE NE 1/4  
OF SECTION 34, TOWN 4 NORTH, RANGE 16 EAST,  
TOWN OF LAGRANGE, WALWORTH COUNTY, WISCONSIN

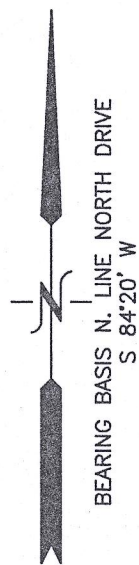

**NORTH DRIVE**  
66' WIDE R.O.W.

**LEGEND**  
○ = FOUND IRON PIPE  
(XXX) = RECORDED AS



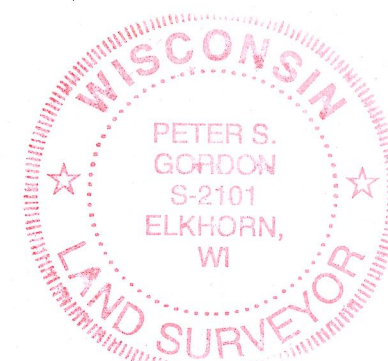


NOTE: COPIES OF THIS MAP TO WHICH THE FOLLOWING CERTIFICATE WILL APPLY SHOW THE SURVEYOR'S ORIGINAL SEAL AND SIGNATURE IN RED INK. COPIES BY ANY OTHER MEANS MAY HAVE ALTERATIONS WHICH DO NOT REPRESENT THE SURVEYOR'S WORK PRODUCT.

I HEREBY CERTIFY THAT THE ABOVE DESCRIBED PROPERTY HAS BEEN SURVEYED UNDER MY DIRECTION AND THAT THE ABOVE MAP IS A TRUE REPRESENTATION THEREOF AND SHOWS THE SIZE AND LOCATION OF THE PROPERTY AND ITS EXTERIOR BOUNDARIES. THIS SURVEY IS MADE FOR THE USE OF THE PRESENT OWNERS OF THE PROPERTY, AND ALSO THOSE WHO PURCHASE, MORTGAGE, OR GUARANTEE THE TITLE THERETO WITHIN ONE YEAR FROM THE DATE HEREOF.

DATED: 09/01/2017

*Peter S. Gordon*  
PETER S. GORDON P.L.S. 2101

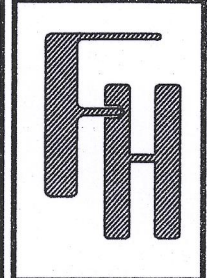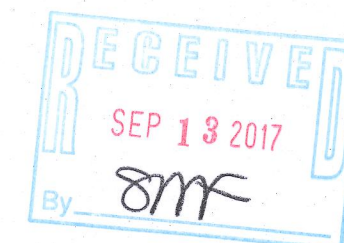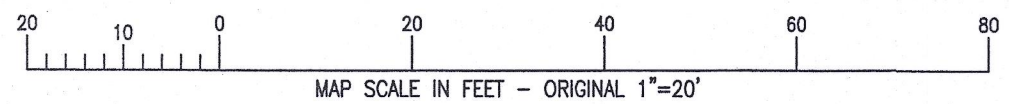

W5712 NORTH DRIVE  
ELKHORN, WI 53124

WORK ORDERED BY -  
WILLIAM GUNDLACH  
1770 WIMBLEDON CT.  
LAKE FOREST, IL 60045

**FARRIS, HANSEN & ASSOCIATES, INC.**  
ENGINEERING - ARCHITECTURE - SURVEYING  
7 RIDGWAY COURT P.O. BOX 437  
ELKHORN, WISCONSIN 53121  
OFFICE: (262) 723-2098 FAX: (262) 723-5866

REVISIONS  
08/01/2017 - LB  
TOPG. SURVEY

PROJECT NO.  
9827  
DATE:  
09/01/2017  
SHEET NO.  
1 OF 1

X:\PROJECTS\9827\ACAD\9827.DWG

4382-37

416-9941

SEP 01 2017