
LAND-MARK SURVEYING Mark L. Miritz

N9330 Knuteson Drive Whitewater, WI 53190 Phone:(262)495-3284 MARKMIRITZ@ LAND-MARKSURVEYING.COM

Wisconsin Professional Land Surveyor S-2582

PLAT OF SURVEY

LOT 3, MERRILL PARK SUBDIVISION, LOCATED IN THE SOUTHWEST 1/4 OF SECTION 26, TOWN 4 NORTH, RANGE 16 EAST, LAGRANGE TOWNSHIP, WALWORTH COUNTY, WISCONSIN.

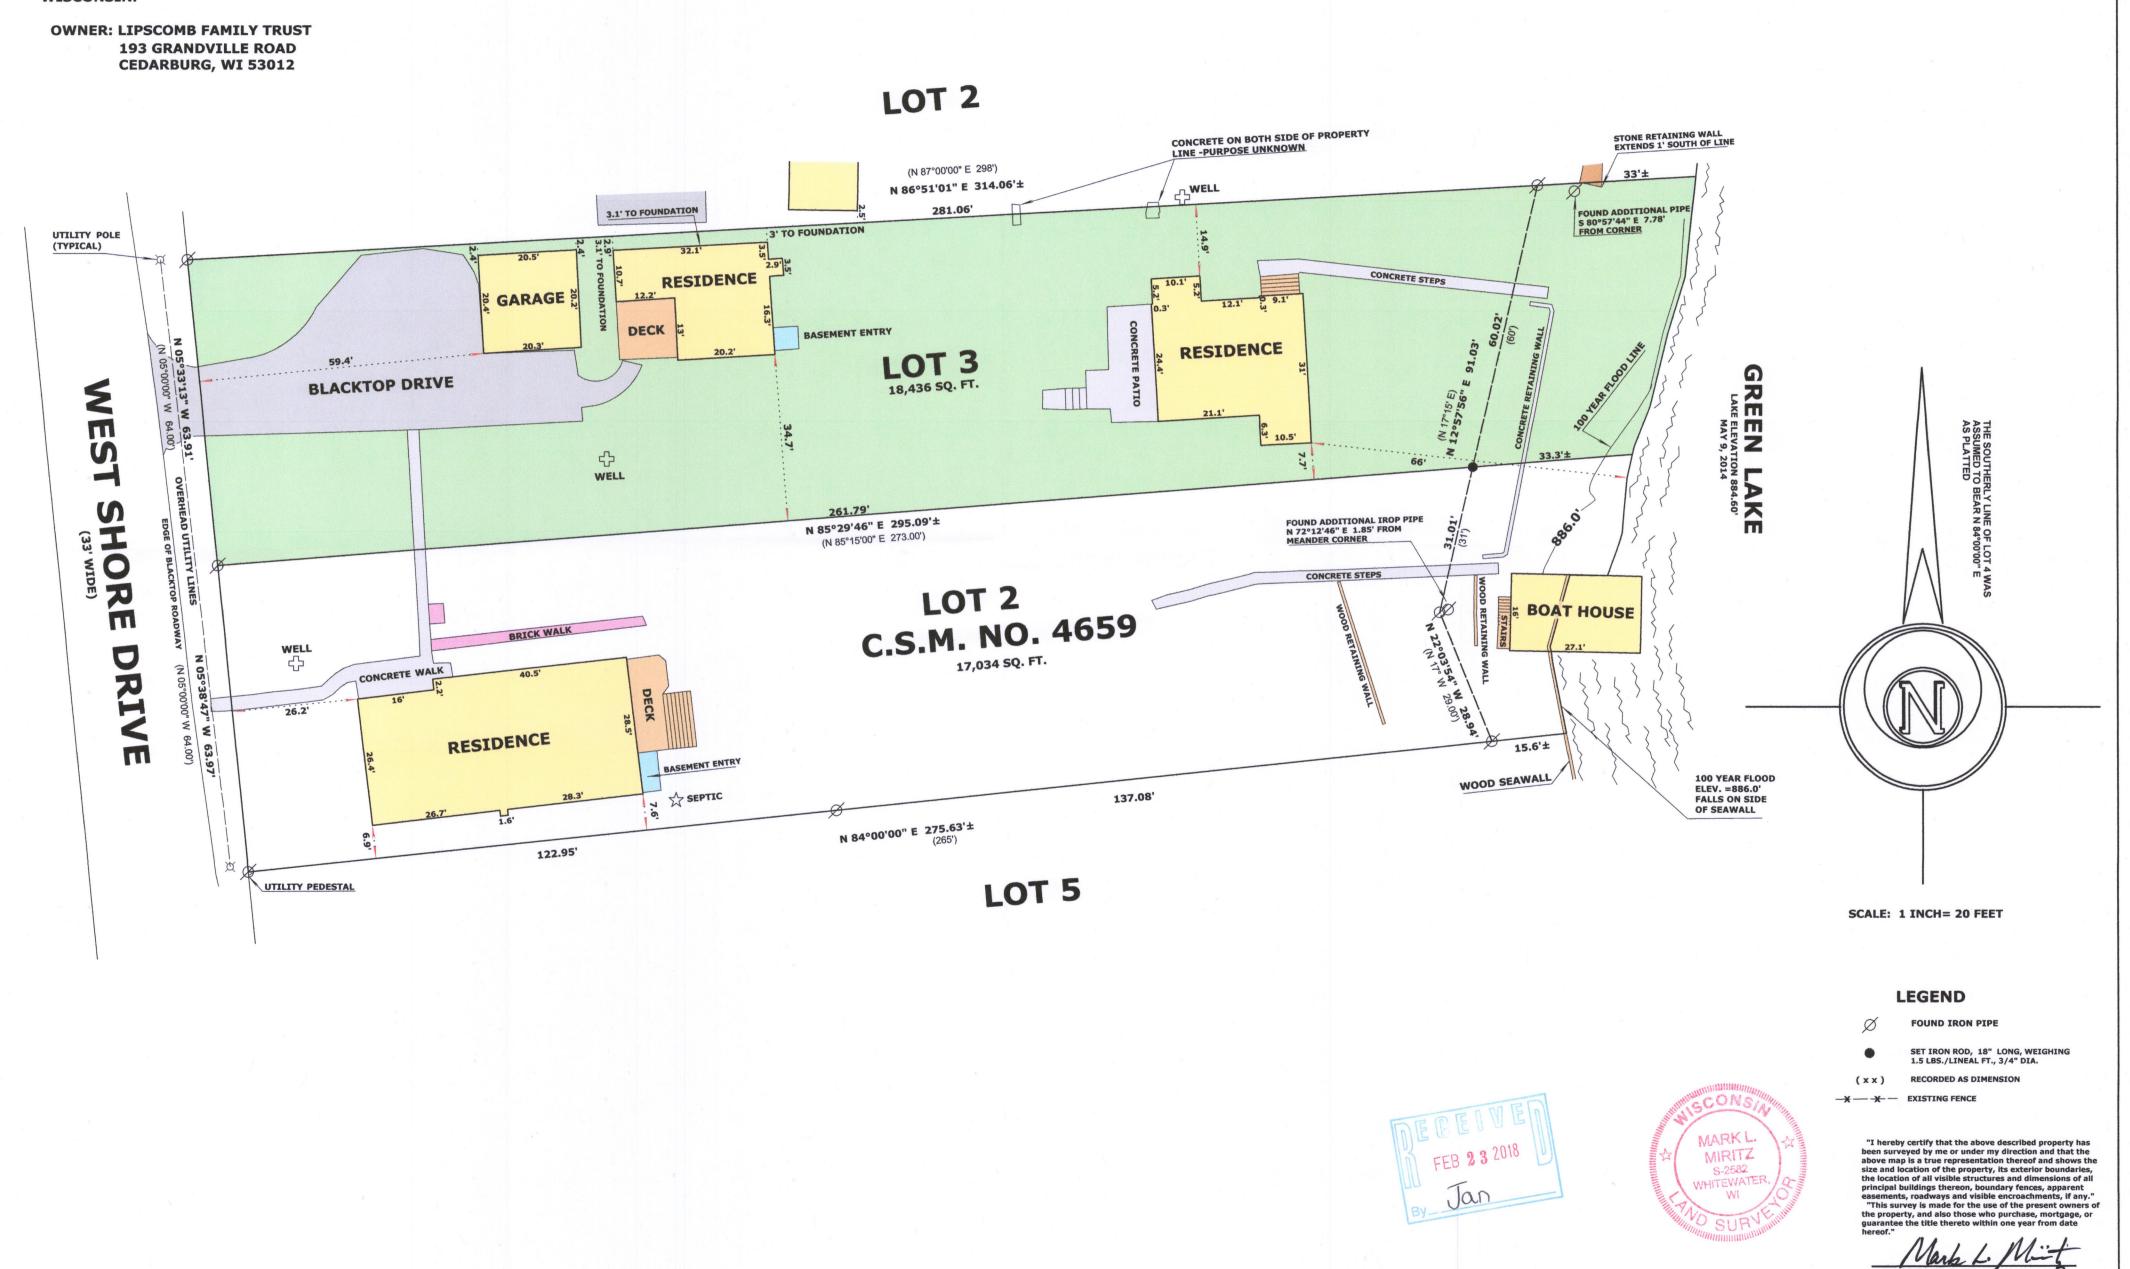

REVISED DEC. 24, 2017 TO

SHOW FOUNDATION TIES

WISCONSIN PROFESSIONAL

DATE: MAY 16, 2014 JOB NO. 14.419

LAND SURVEYOR S-2582