


PLAT OF SURVEY OF LOT 7 BLOCK 3 BAY VIEW MANOR
 A SUBDIVISION LOCATED IN SECTION 36, T4N R16E,
 WAK. CO. WIS.

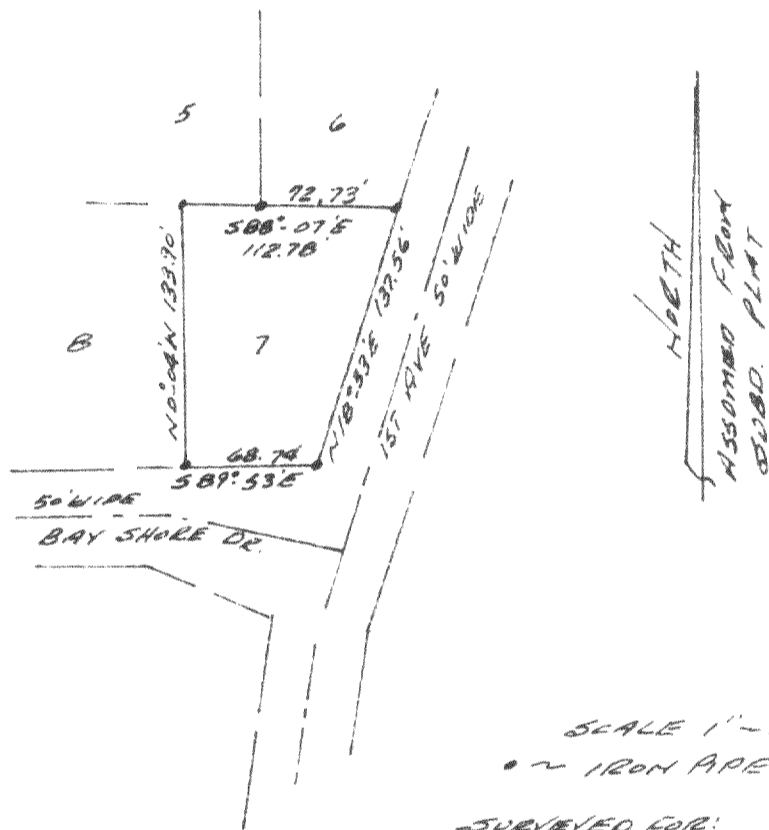

SURVEYED FOR:

MANHUS PETERSON + SON
 RT 1 BOX 102
 GENOA CITY, WIS 53121

I CERTIFY THAT I HAVE SURVEYED
 THE ABOVE DESCRIBED LAND AND
 THAT THIS PLAT IS AN ACCURATE
 REPRESENTATION OF SAID SURVEY.

MAY 11, 1979

HENSEN SURVEYING
 &
 MAPPING
 ELKHORN, WIS.

