

MIDDLE LAKE

Farris, Hansen & Associates, Inc.

Engineering, Surveying & Land Planning

P.O. BOX 487

715 W. WALWORTH STREET
ELKHORN, WISCONSIN 53121

PLAT OF SURVEY OF
Lot 3, Block 7, Cool
Hill Park Addition No. 1,
Town of La Grange,
Walworth County,
Wisconsin.

WORK ORDERED BY OWNER:

Joeseeph Benda
909 Greenview Road
Itasca, IL 60143


SCALE 1" = 30'

(1) - RECORD
DIMENSION

I HEREBY CERTIFY that under my
supervision the property des-
cribed hereon has been surveyed
and that this plat is a true
and accurate representation thereof

Robert A. Farris

ROBERT A. FARRIS, RLS No. 1293
Dated this 17th day of March, 1983.

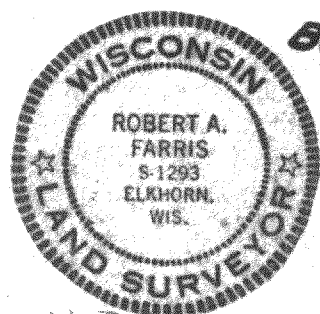

BUBBLING

SPRINGS

(66' WIDE)

PROJECT NO. 2054

FOUND
1 3/16" ROD

(106.03')

(N 77°30'W) N 77°38'W

FOUND 11/16" ROD - BENT -
STRAIGHTENED AND RESET

26.00'

FOUND 1 3/16" ROD -
BENT -
STRAIGHTENED
AND RESET

58.93' N 50°32'E (N 50°31'E)

DRIVE

POWER
POLE

FOUND 11/16" ROD (96.00')

FOUND 1 3/16" ROD

95.37'

10.9'

FOUND 11/16" ROD
0.3' OFF LINE TO THE
WEST

N 18°20'W

TO

THIS LINE ASSUMED SHOWN
TO BE ON ORIGINAL PLAT

98.37'

FOUND 11/16" ROD

77.00'

N 73°24'E

(N 73°23'E)

FOUND 11/16" ROD

(35')

(30.3')

N 18°14'W

203.98'

(N 18°13'W)

EXISTING
RESIDENCE

LOT 3