PREPARED FOR SCOTT & CHERYL DILLNER

PLAT OF SURVEY

- OF -

Lot 4 Cali Acres Subdivision, located in the Southwest 1/4 of Section 35, Township 4 North, Range 16 East, Town of Lagrane, County of Walworth and State of Wisconsin.

PATHFINDER SURVEYING


(a NMB Company)


P.O BOX 322

LAKE GENEVA, WI. 53147

WWW.PATHFINDERSURVEYING.NET

262-248-8303

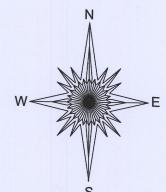

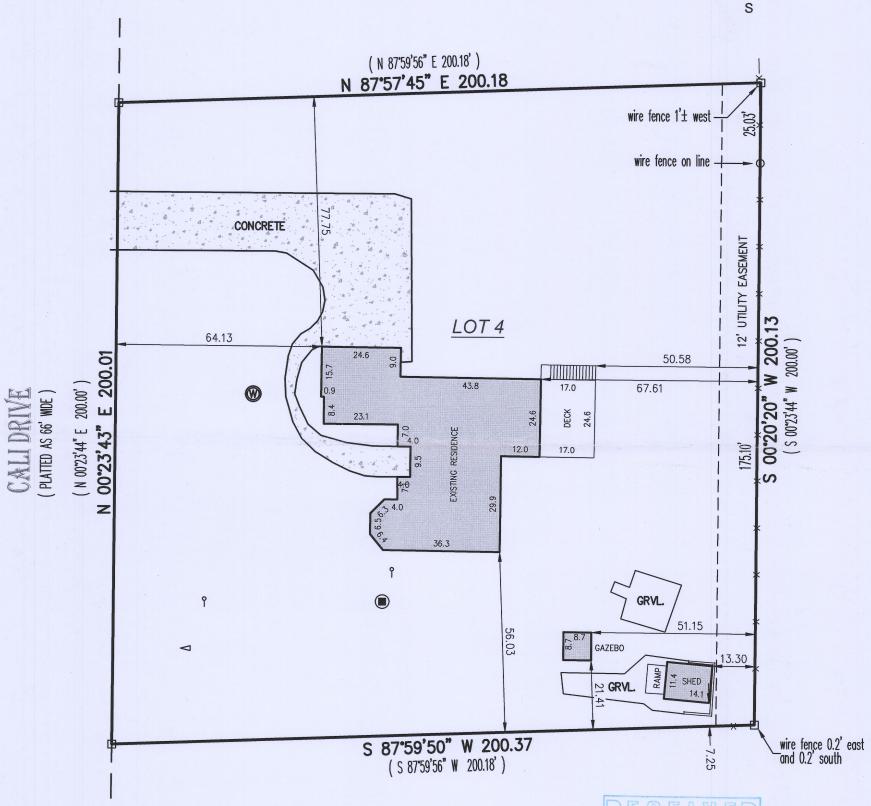

() = recorded as

= found iron pipe

= found iron bar

= concrete lid

? = clean out


w = well

—X— = fence

SCALE 1" = 30'

JOB # 2018.0144.01

TAX ID # HC 00004

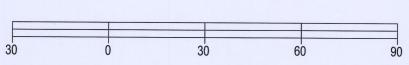

BASIS OF BEARING OF THIS PLAT: THE SUBDIVISION PLAT OF RECORD.

I hereby certify that I have surveyed the above- described property and the above map is a is a true representation thereof and shows the size and location of the property, its exterior boundaries, the location and dimensions of all structures thereon, fences, apparent easements and roadways and visible encroachments if any to the best of my knowledge and belief.

This survey is made for the present owners of the property, and those who purchase, mortgage, or guarantee the title thereto, within one year from the date hereof.

DATED THIS 18TH DAY OF MAY, 2018.



医医肾儿儿原

JUL 25 2018

MARK R. MADSEN S - 2271 Wisconsin Professional Land Surveyor