

Plat of Survey



of Unit 3B of Lauderdale Shores A Recreational Vehicle Condominium,

located in Government Lot 3 in the Northwest 1/4 of
Section 25, Town 4 North, Range 16 East, Town of
LaGrange, Walworth County, Wisconsin.

Surveyed for: **Tim Gallagher**
375 Holly Avenue
Elmhurst, Illinois. 60126



Bearings reference to the plat of Lauderdale
Shores A Recreational Vehicle Condominium.

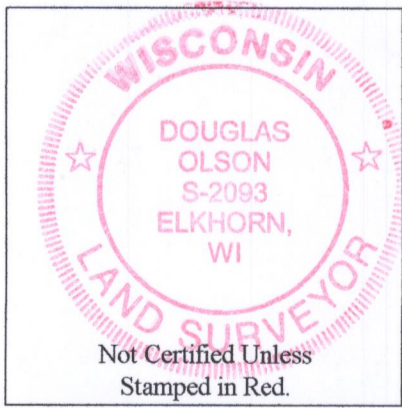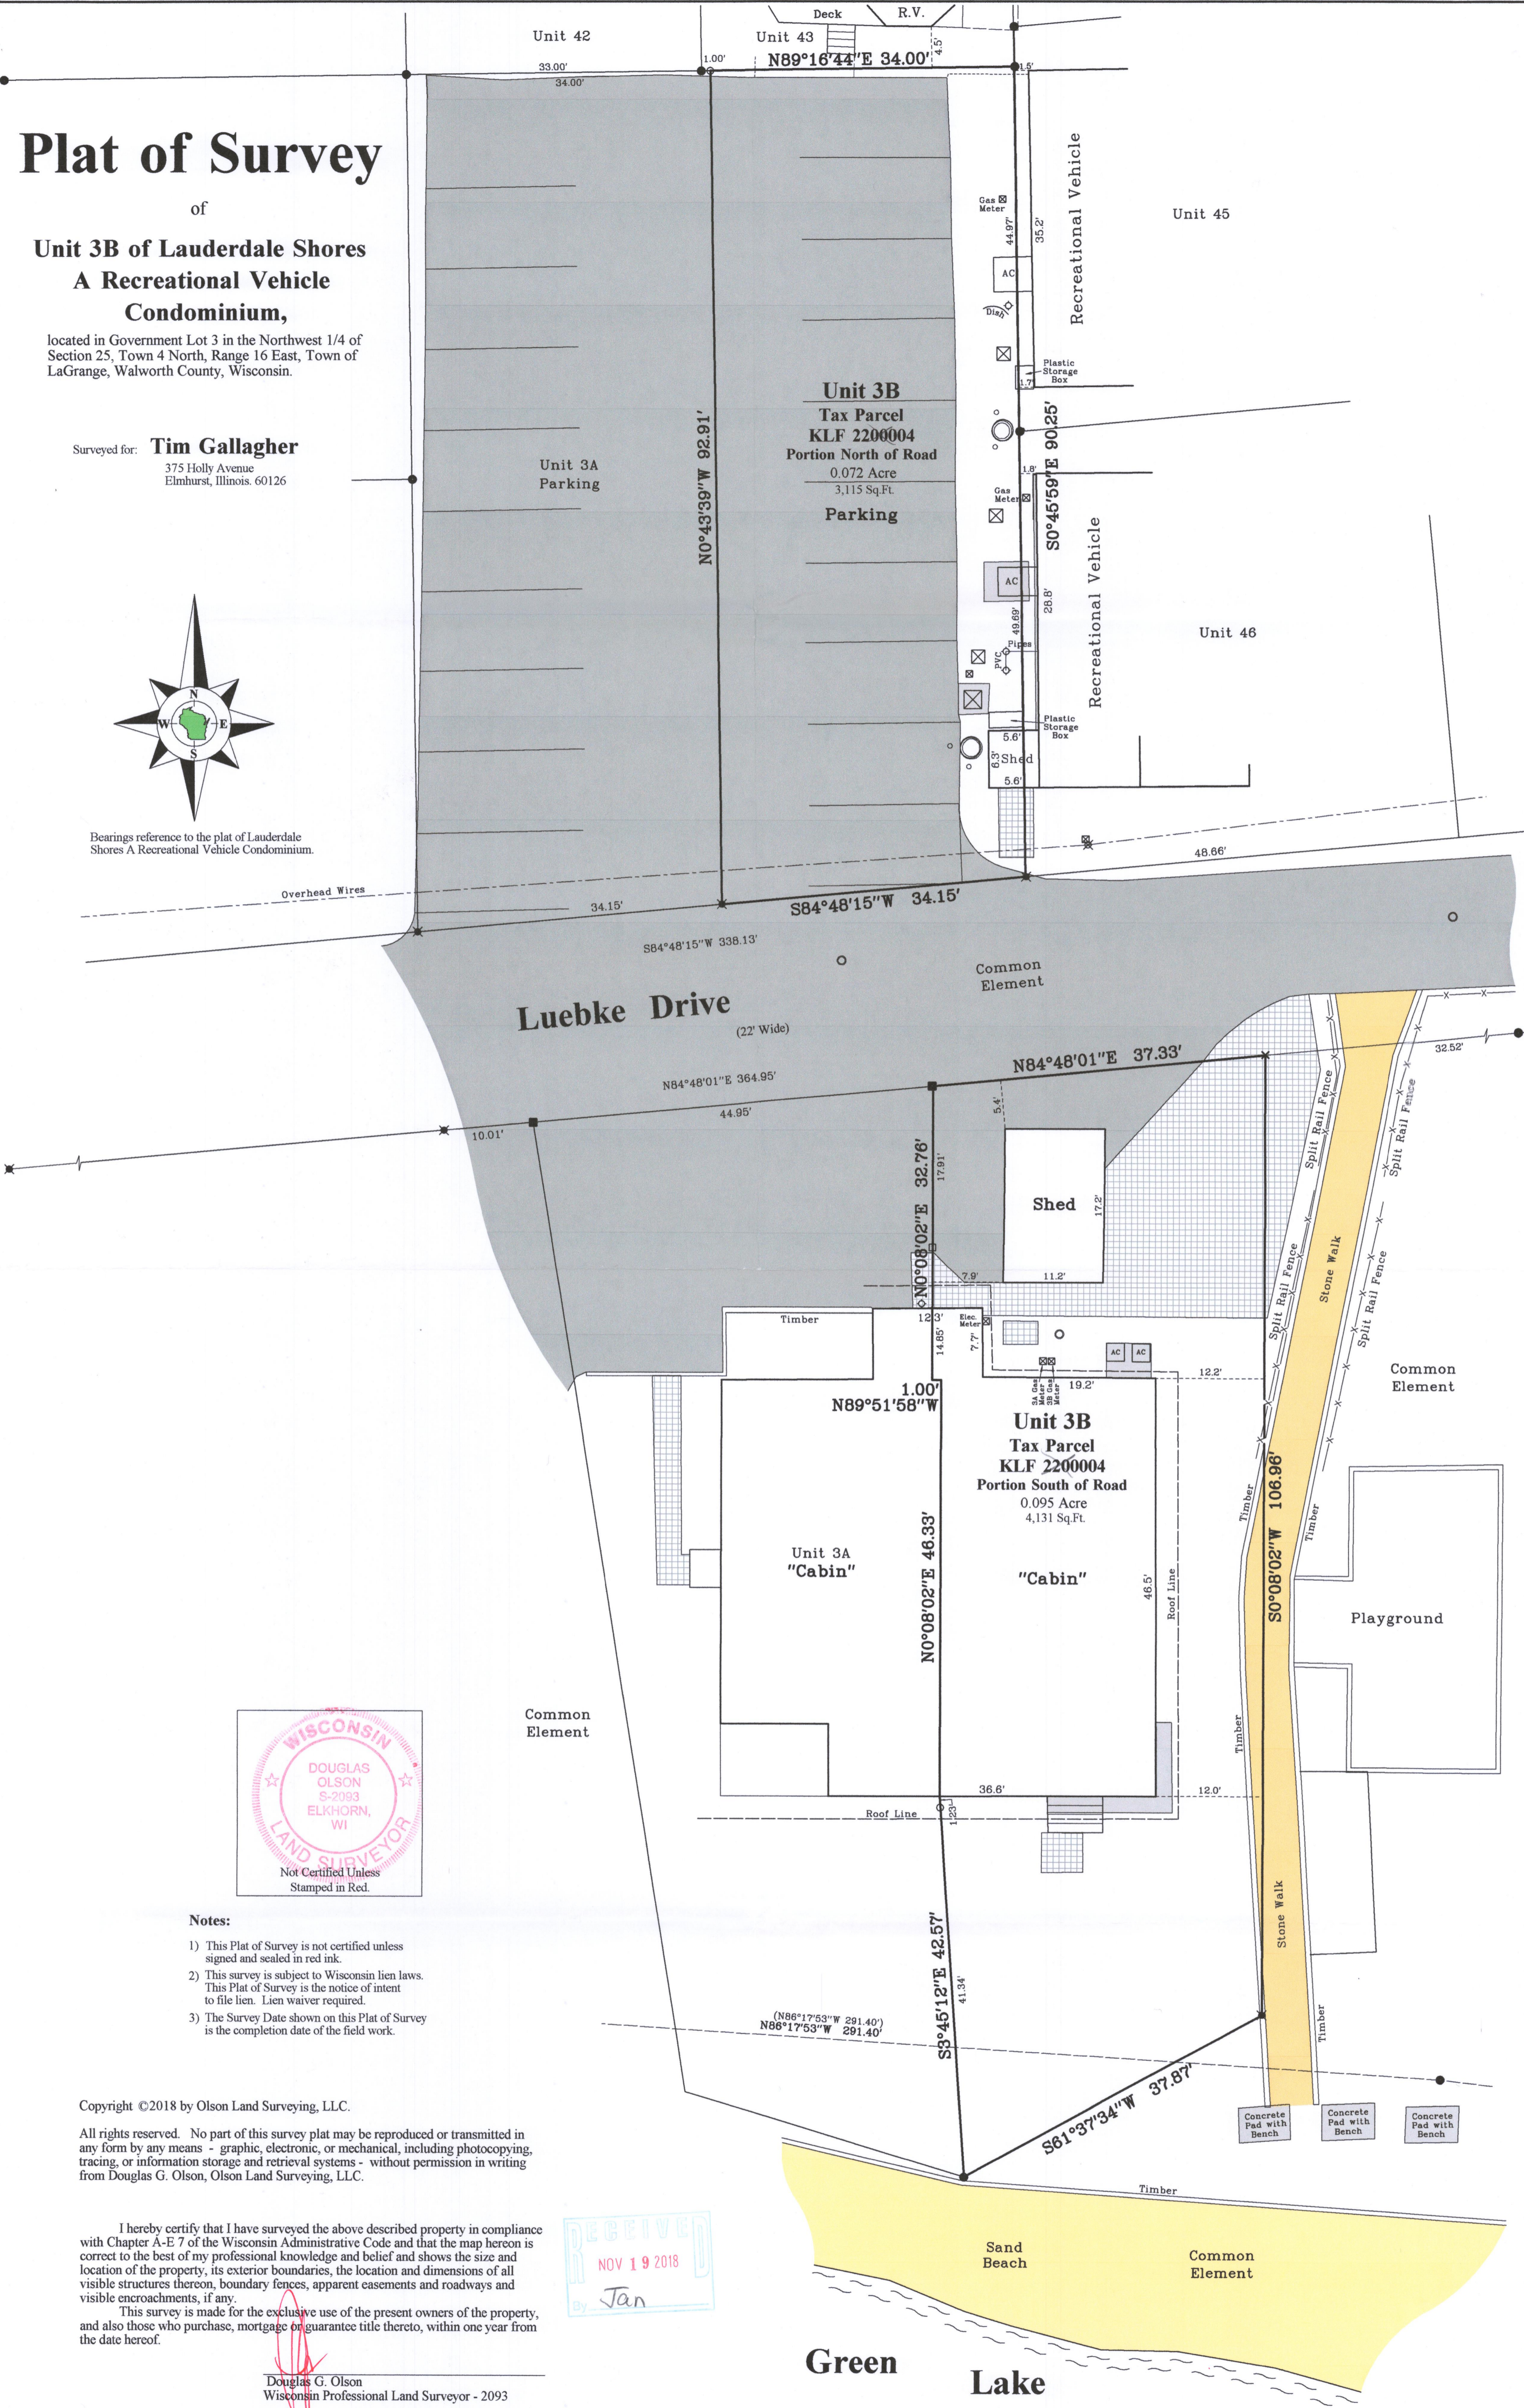

Notes:

- 1) This Plat of Survey is not certified unless signed and sealed in red ink.
- 2) This survey is subject to Wisconsin lien laws. This Plat of Survey is the notice of intent to file lien. Lien waiver required.
- 3) The Survey Date shown on this Plat of Survey is the completion date of the field work.


Copyright ©2018 by Olson Land Surveying, LLC.

All rights reserved. No part of this survey plat may be reproduced or transmitted in any form by any means - graphic, electronic, or mechanical, including photocopying, tracing, or information storage and retrieval systems - without permission in writing from Douglas G. Olson, Olson Land Surveying, LLC.

I hereby certify that I have surveyed the above described property in compliance with Chapter A-E 7 of the Wisconsin Administrative Code and that the map hereon is correct to the best of my professional knowledge and belief and shows the size and location of the property, its exterior boundaries, the location and dimensions of all visible structures thereon, boundary fences, apparent easements and roadways and visible encroachments, if any.

This survey is made for the exclusive use of the present owners of the property, and also those who purchase, mortgage or guarantee title thereto, within one year from the date hereof.

Douglas G. Olson
Wisconsin Professional Land Surveyor - 2093

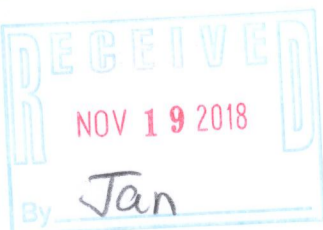

2017.147

Sheet 1 of 1 Sheets

Drawing Name:

Job Reference Number
2017.147


Legend of Symbols & Abbreviations

- Found Iron Rod
- Found Railroad Spike
- Set Iron Pipe, 1" dia.
- Recorded Information
- Utility Pole
- Utility Box or Pedestal
- Concrete Cover or Manhole
- Asphalt Surface
- Concrete Surface
- Found Mag Nail
- Set Cut Cross
- Set Mag Nail
- Bollard
- Brick Pavers



45 South Wisconsin Street | P.O. Box 322
Elkhorn, Wisconsin. 53121
Telephone: (262) 723-3434
Facsimile: (262) 723-8044
Email: doug@olsonsurveying.com
Website: www.olsonsurveying.com

Scale in Feet
1" = 10'

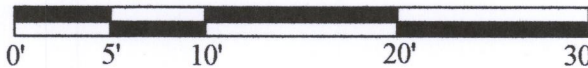

Survey Date: June 15, 2018.

Revisions:

HLAS-3B
416-3051