

**LAND-MARK SURVEYING**

Mark L. Miritz

Wisconsin Professional Land Surveyor S-2582



N9330 Knuteson Drive  
Whitewater, WI 53190  
Phone: (262)495-3284  
MARKMIRITZ@  
LAND-MARKSURVEYING.COM

OWNER:  
ROBIN I COMER  
SARAH R INGLE TRUST  
P.O. BOX 2007  
RANCHO SANTA FE, CA 92067

SITE ADDRESS:  
W5330 WEST SHORE DR.  
ELKHORN, WI 53121

**PLAT OF SURVEY**

LOT 11 OF INGLESIDE POINT SUBDIVISION, LOCATED  
IN THE SOUTHEAST 1/4 OF SECTION 26, TOWN 4 NORTH,  
RANGE 16 EAST, TOWN OF LAGRANGE, WALWORTH  
COUNTY, WISCONSIN.

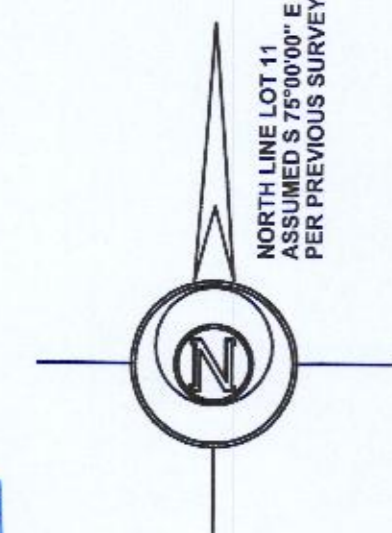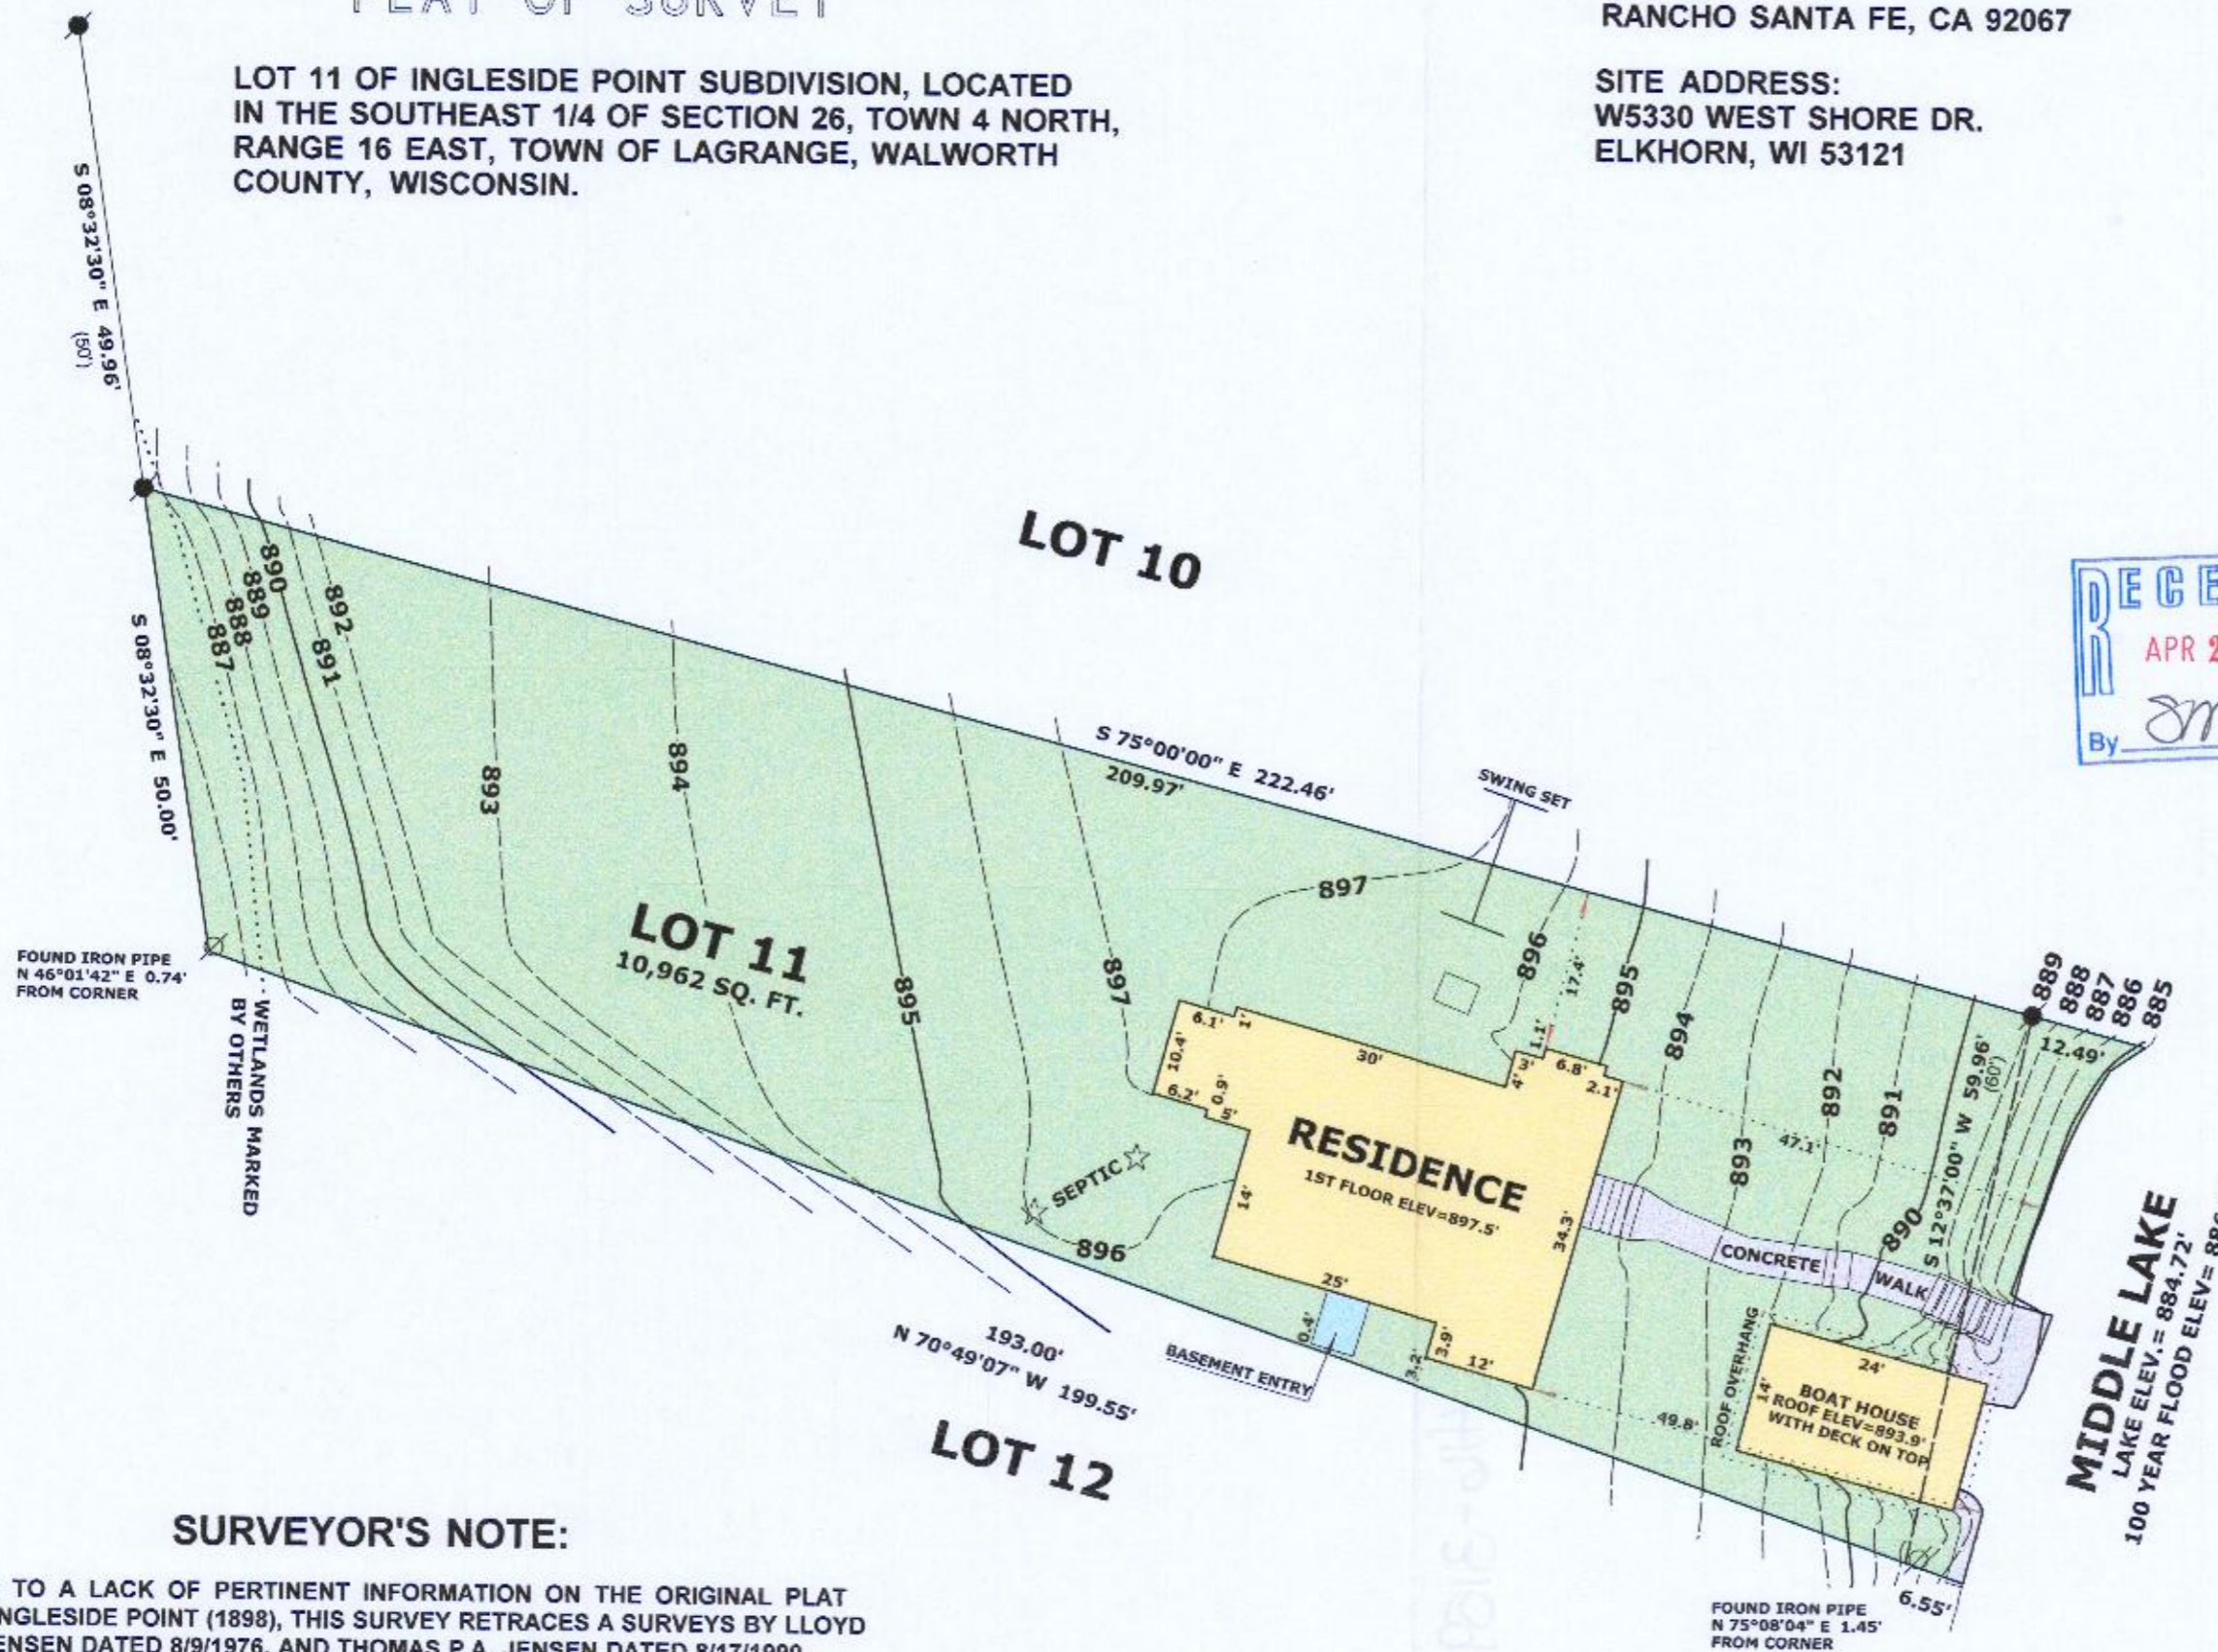

**LEGEND**

- FOUND IRON PIPE
- FOUND IRON ROD
- RECORDED AS DIMENSION

SCALE: 1 INCH = 20 FEET

"I hereby certify that the above described property has been surveyed by me or under my direction and that the above map is a true representation thereof and shows the size and location of the property, its exterior boundaries, the location of all visible structures and dimensions of all principal buildings thereon, boundary fences, apparent easements, roadways and visible encroachments, if any."  
"This survey is made for the use of the present owners of the property, and also those who purchase, mortgage, or guarantee the title thereto within one year from date hereof."

*Mark L. Miritz*  
MARK L. MIRITZ  
WISCONSIN PROFESSIONAL  
LAND SURVEYOR S-2582

DATE: JAN. 12, 2020 JOB NO. 20.104

**SURVEYOR'S NOTE:**

DUE TO A LACK OF PERTINENT INFORMATION ON THE ORIGINAL PLAT OF INGLESIDE POINT (1898), THIS SURVEY RETRACES A SURVEYS BY LLOYD L. JENSEN DATED 8/9/1976, AND THOMAS P.A. JENSEN DATED 8/17/1990.

HIP-2

4110-3159