
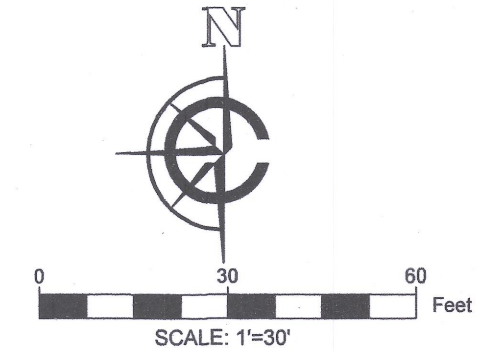


LEGEND

●	FOUND 1" IRON PIPE		EXISTING CONCRETE PATIO
●	FOUND 1.5" IRON PIPE		EXISTING ASPHALT DRIVE
○	SET 1" IRON PIPE		EXISTING DECK
△	SET MAG NAIL		EXISTING BUILDING
(XX)	RECORDED AS		

PLAT OF SURVEY

A PARCEL OF LAND LOCATED IN THE SOUTHWEST 1/4 OF THE SOUTHEAST 1/4 OF SECTION 36 IN TOWNSHIP 4 NORTH, RANGE 16 EAST, IN THE TOWN OF LAGRANGE, WALWORTH COUNTY, WISCONSIN.

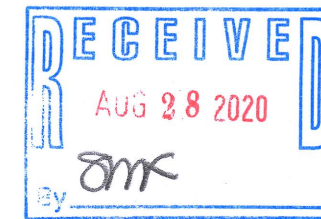


NOTE:
 1. BASIS OF BEARING: THE WISCONSIN STATE PLANE COORDINATE SYSTEM, NAD-83, SOUTH ZONE.
 2. FIELD WORK COMPLETED DECEMBER 31ST, 2019
 3. BUILDING SURVEYED TO THE EXTERIOR OF SIDING.

LEGAL DESCRIPTION:

A PARCEL OF LAND LOCATED IN THE SOUTHWEST 1/4 OF THE SOUTHEAST 1/4 OF SECTION 36 IN TOWNSHIP 4 NORTH, RANGE 16 EAST, IN THE TOWN OF LAGRANGE, WALWORTH COUNTY, WISCONSIN, MORE PARTICULARLY DESCRIBED AS:

LOT 2 OF CSM #1996 RECORDED IN DOCUMENT #205891 IN THE WALWORTH COUNTY REGISTER OF DEEDS.

UNPLATTED LANDS
 HA349700001

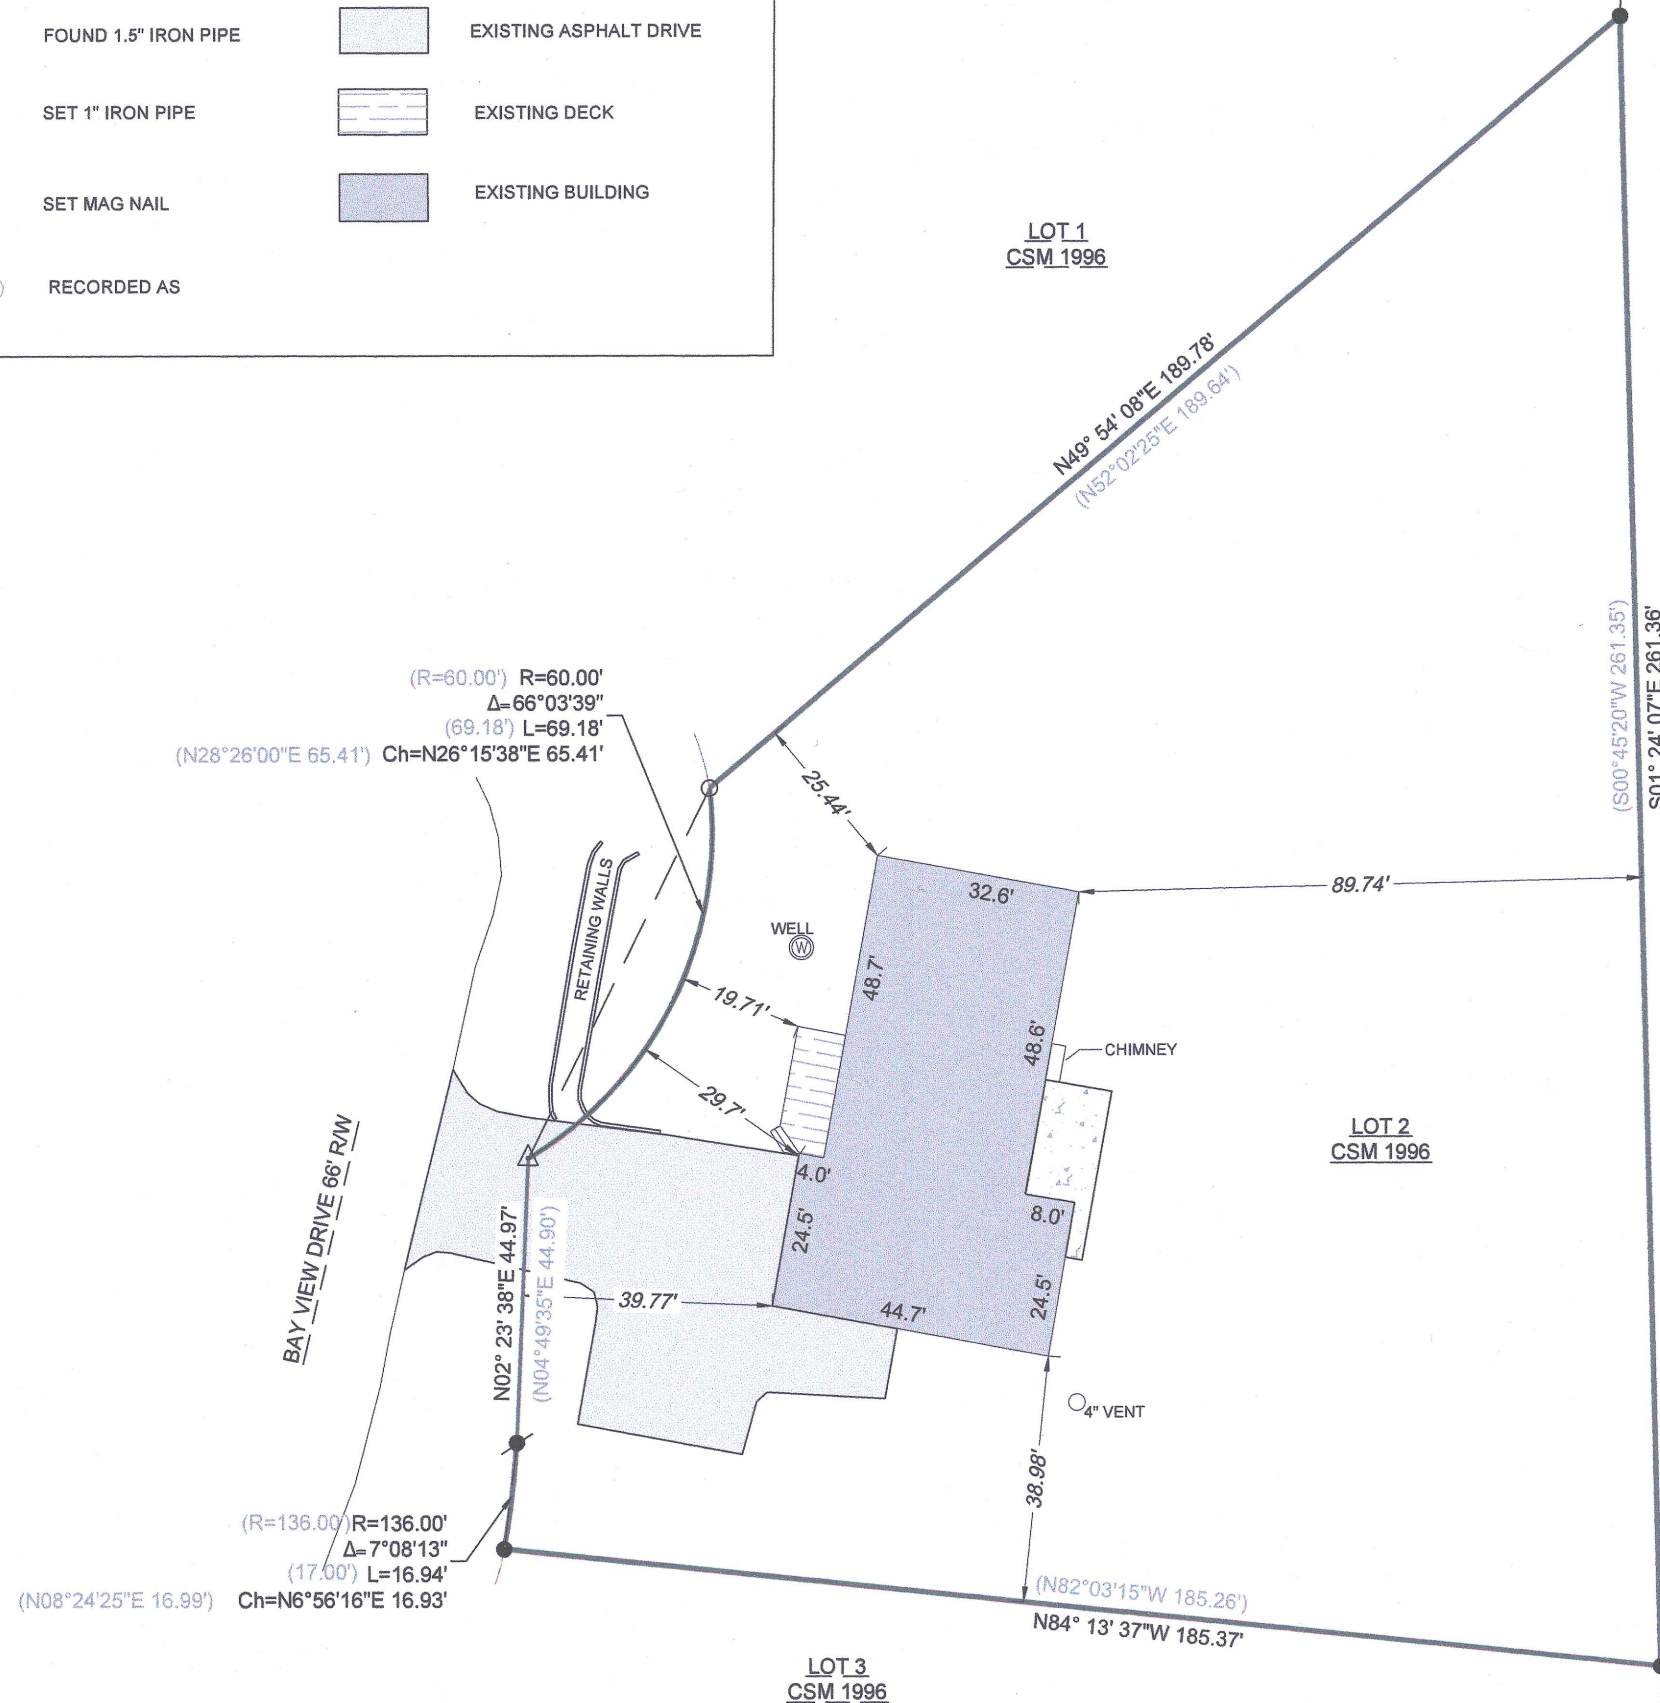

HA1996-2

416-3192