


FARRIS, HANSEN & ASSOCIATES, INC.

ENGINEERING, SURVEYING & LAND PLANNING

715 W. WALWORTH ST. - BOX 487 - ELKHORN, WI.

PHONE: 414-723-2098

I hereby certify that I have surveyed the above described property and that the above map is a true representation thereof and shows the size and location of the property, its exterior boundaries, the location of all visible structures and dimensions of all principal buildings thereon, boundary fences, apparent easements, roadways and visible encroachments, if any. This survey is made for the use of the present owners of the property, and also those who purchase, mortgage, or guarantee the title thereto within one (1) year from date hereof.

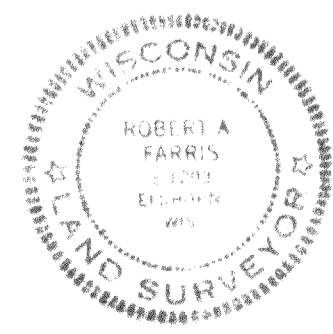

Robert A. Farris
ROBERT A. FARRIS

REVISED 11/30/83 TO SHOW LOCATION OF PROPOSED RESIDENCE AND NEW BOUNDARY LINE PROPOSED

- ⊕ = IRON PIPE SET
- = FOUND IRON PIPE
- ⊙ = FOUND CONC. MONUMENT
- (xxx) = RECORD DIMENSION

EAST LINE LOT 1
ASSUMED TO BEAR N 4° 01' W
AS RECORDED



PLAT OF SURVEY OF LOT 1 & 2 OF HILLVIEW PARK, A SUBDIVISION LOCATED IN NW 1/4 SEC. 35, T. 4 N., R. 16 E., WALWORTH CO., WIS.

FOR CHARLOTTE SWANSON C/O AL ROCKWELL

DATED NOVEMBER 7, 1983

PROJ. 2180