




PLAT OF SURVEY  
LOT 2 OF CERTIFIED SURVEY MAP NO. 4953  
LOCATED IN PART OF THE NW 1/4 OF THE NW 1/4  
OF SECTION 35, TOWN 4 NORTH, RANGE 16 EAST,  
TOWN OF LAGRANGE, WALWORTH COUNTY, WISCONSIN

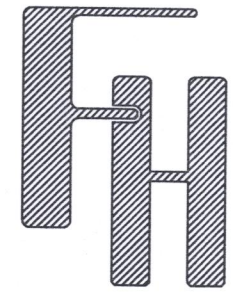


PLAT OF SURVEY  
MILLER RESIDENCE  
EAST OF W5659 PARK ROAD  
ELKHORN, WI 53121

WORK ORDERED BY -  
THELEN TOTAL CONSTRUCTION  
P.O. BOX 17  
ELKHORN, WI 53121

FARRIS, HANSEN & ASSOCIATES, INC.  
ENGINEERING - ARCHITECTURE - SURVEYING  
7 RIDGWAY COURT P.O. BOX 437  
ELKHORN, WISCONSIN 53121  
OFFICE: (262) 723-2098 FAX: (262) 723-5886

REVISIONS

PROJECT NO.  
10296  
DATE  
06/09/2021  
SHEET NO.  
1 OF 1

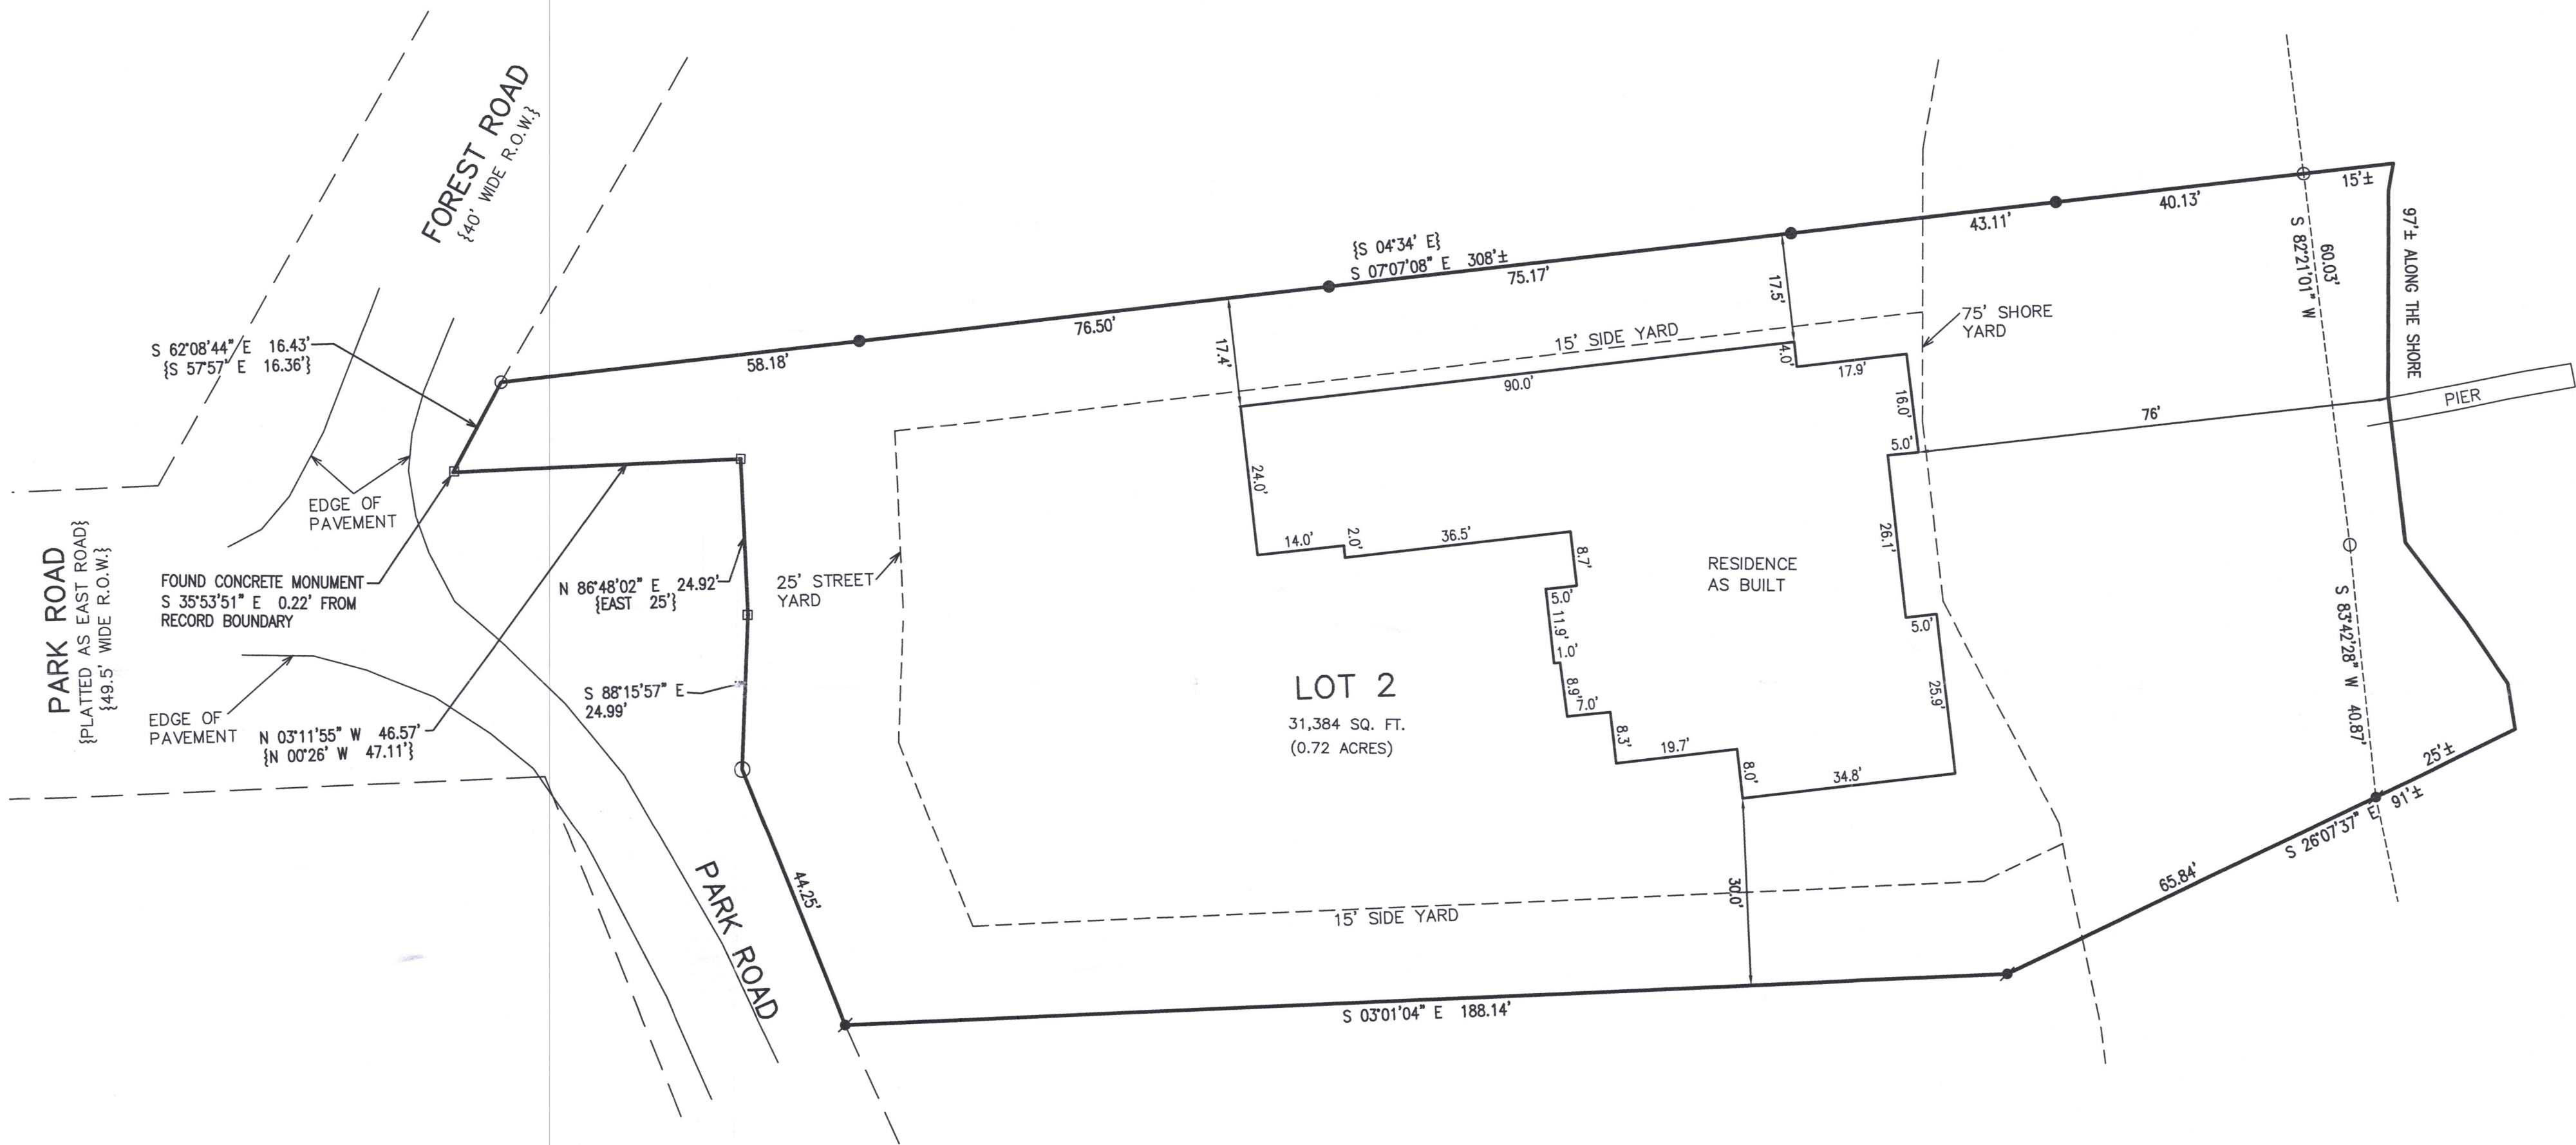

- LEGEND
- ▣ = FOUND CONCRETE MONUMENT
  - △ = FOUND MAGNETIC NAIL
  - = FOUND IRON PIPE STAKE
  - = FOUND REBAR STAKE
  - ✦ = SET REBAR STAKE



NOTE: COPIES OF THIS MAP TO WHICH THE FOLLOWING CERTIFICATE WILL APPLY SHOW THE SURVEYOR'S ORIGINAL SEAL AND SIGNATURE IN RED INK. COPIES BY ANY OTHER MEANS MAY HAVE ALTERATIONS WHICH DO NOT REPRESENT THE SURVEYOR'S WORK PRODUCT.

I HEREBY CERTIFY THAT THE ABOVE DESCRIBED PROPERTY HAS BEEN SURVEYED UNDER MY DIRECTION AND THAT THE ABOVE MAP IS A TRUE REPRESENTATION THEREOF AND SHOWS THE SIZE AND LOCATION OF THE PROPERTY AND ITS EXTERIOR BOUNDARIES. THIS SURVEY IS MADE FOR THE USE OF THE PRESENT OWNERS OF THE PROPERTY, AND ALSO THOSE WHO PURCHASE, MORTGAGE, OR GUARANTEE THE TITLE THERETO WITHIN ONE YEAR FROM THE DATE HEREOF.



DATED: 04/02/2021  
REVISED 6/9/2021  
TO SHOW RESIDENCE  
AS BUILT

*CHAH*  
CHRISTOPHER A. HODGES P.L.S. 2760

X:\PROJECTS\10296\ACAD\10296 ASBUILT.dwg



HA4953-2

416-3380