


Plat of Survey

of

Lot 15 of Strawberry Banke Plantation,

a subdivision located in the Northeast 1/4 of the Northwest 1/4 of Section 1, Town 3 North, Range 16 East, Town of Sugar Creek, and the Southeast 1/4 of the Southwest 1/4 of Section 36, Town 4 North, Range 16 East, Town of LaGrange, Walworth County, Wisconsin.

Surveyed for: **Mike Roberts**
609 West Centralia Street
Elkhorn, Wisconsin. 53121

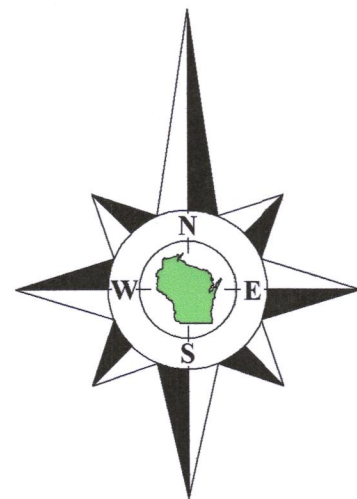

Bearings referenced to the South line of Lots 11 & 12, recorded as N44°47'E on the plat of Strawberry Banke Plantation, which produces a bearing of S89°24'46"W on the North line of the Northwest 1/4 of Section 1-3-16. A rotation of 2°10'22" from the Wisconsin State Plane Coordinate System, South Zone, (NAD-27).

Coordinates are referenced to the Wisconsin State Plane Coordinate System, South Zone, (NAD-27).

Plantation Road
(76' Wide)

Tax Parcel
HSP 00015
Town of LaGrange

Lot 15
0.445 Acre
19,387 Sq.Ft.

Lot 16

Lot 14

Wooded

Tax Parcel
GSP 00015A
Town of Sugar Creek

North 1/4 Corner
Section 1-3-16
(N. 279,178.07)
(E. 2,388,412.76)



Notes:

- 1) This Plat of Survey is not certified unless signed and sealed in red ink.
- 2) This survey is subject to Wisconsin lien laws. This Plat of Survey is the notice of intent to file lien. Lien waiver required.
- 3) The Survey Date shown on this Plat of Survey is the completion date of the field work.

Copyright © 2021 by Olson Land Surveying, LLC.

All rights reserved. No part of this survey plat may be reproduced or transmitted in any form by any means - graphic, electronic, or mechanical, including photocopying, tracing, or information storage and retrieval systems - without permission in writing from Douglas G. Olson, Olson Land Surveying, LLC.

I hereby certify that I have surveyed the above described property in compliance with Chapter A-E 7 of the Wisconsin Administrative Code and that the map hereon is correct to the best of my professional knowledge and belief and shows the size and location of the property, its exterior boundaries, the location and dimensions of all visible structures thereon, boundary fences, apparent easements and roadways and visible encroachments, if any.

This survey is made for the exclusive use of the present owners of the property, and also those who purchase, mortgage or guarantee title thereto, within one year from the date hereof.

Douglas G. Olson
Wisconsin Professional Land Surveyor - 2093

Sheet 1 of 1 Sheets

Drawing Name:

Job Reference Number
2021.085

Legend of Symbols & Abbreviations

- Found County Section Corner
 - Found Iron Pipe
 - Set Iron Pipe, 1" dia.
 - Recorded Information
 - Utility Pole
 - Utility Pedestal
 - Concrete Cover
 - Septic Vent
 - Asphalt Surface
- N North
S South
E East
W West
In Bearings
° Degrees
' Minutes
" Seconds
In Distances
Feet
Inches



45 South Wisconsin Street | P.O. Box 322
Elkhorn, Wisconsin. 53121
Telephone: (262) 723-3434
Facsimile: (262) 723-8044
Email: doug@olsonsurveying.com
Website: www.olsonsurveying.com

Scale in Feet
1" = 20'



Survey Date: July 14, 2021.

Revisions:

2021.085

HSP-15 GSP-15A

416-3286