

Engineering, Surveying & Land Planning
P.O. BOX 487
715 W. WALWORTH STREET
ELKHORN, WISCONSIN 53121

PLAT OF SURVEY OF
Lot 71, Bubbling Springs 1st Addition,
Town of LaGrange, Walworth County, Wisconsin.


LEGEND

Work Ordered By:

Bob Rogowski
1840 W. 22nd Pl
Chicago, IL 60608

○ - 2" Iron Pipe Found


() - Record Dimension

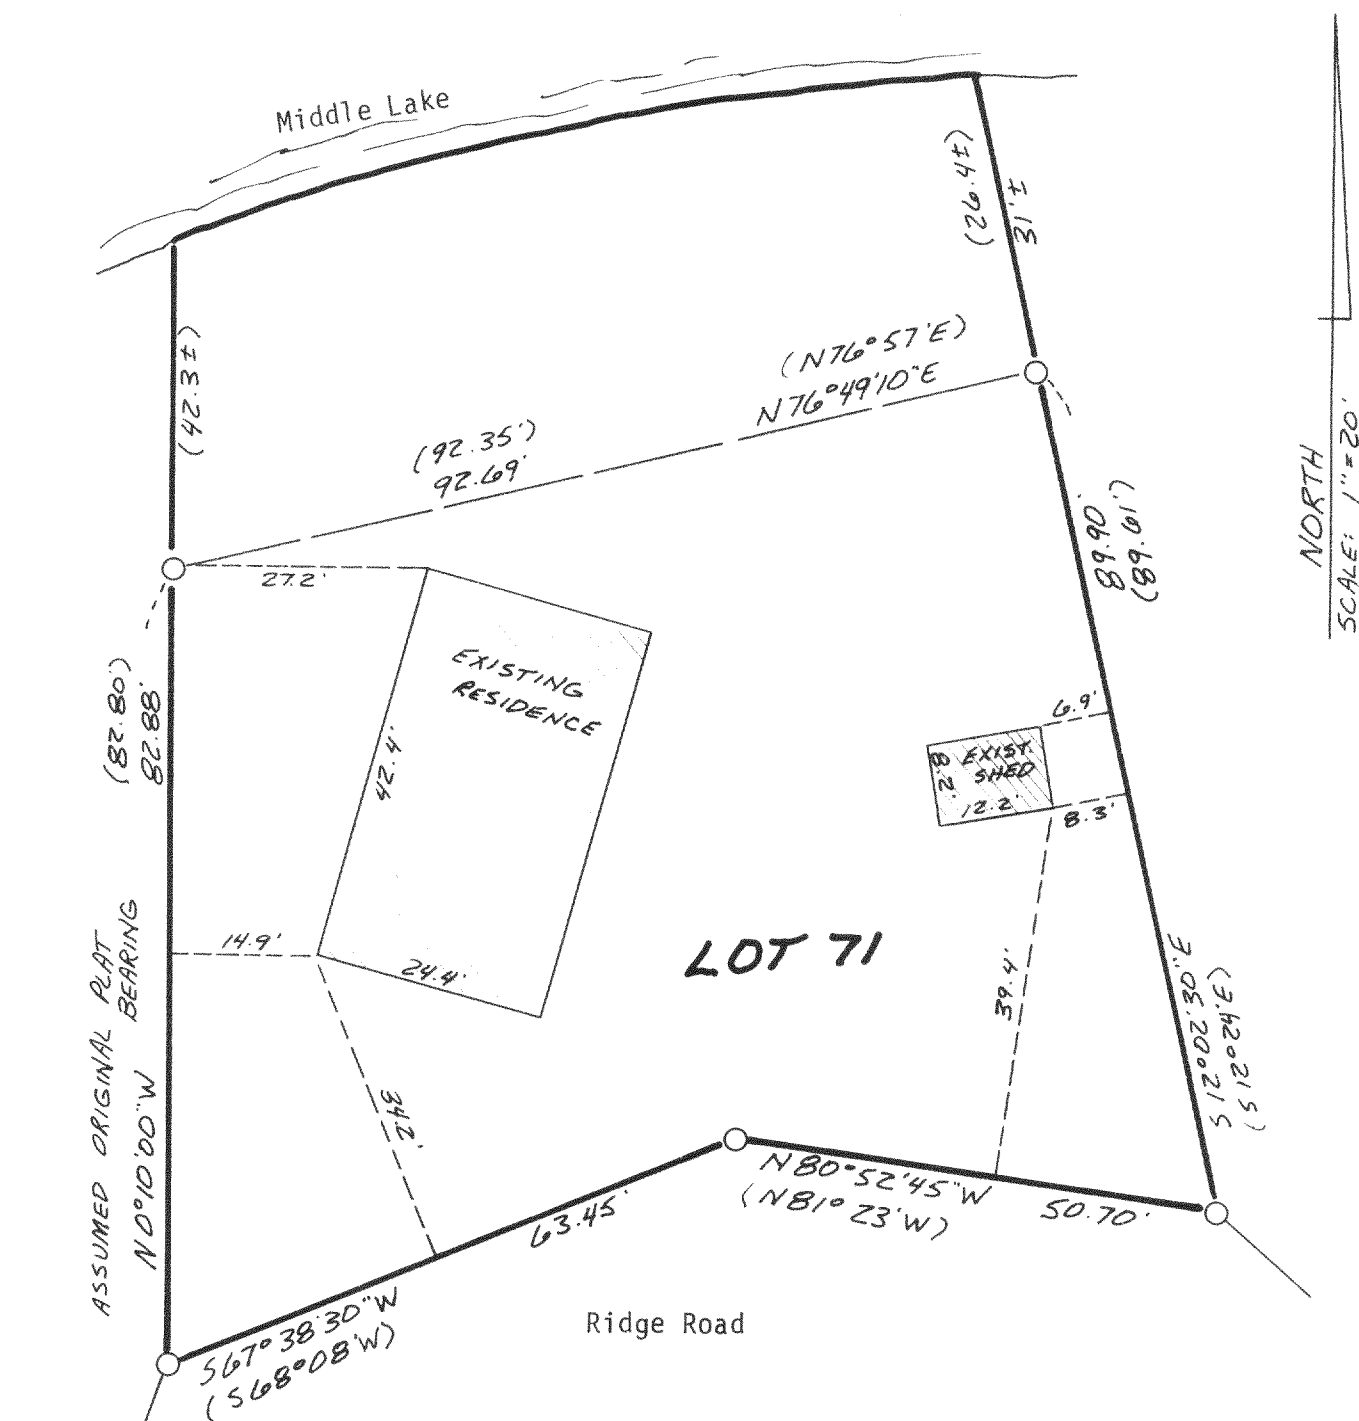

I hereby certify that the above described property was surveyed under my direction and that this Plat is a true and accurate representation thereof to the best of my professional knowledge and belief.

Robert A. Farris
Robert A. Farris, R.L.S.

Dated this 29th day of June, 1984

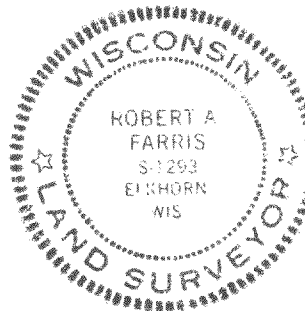

Sheet 1 of 1

PROJECT #2279

4BS1-40

416-328-F