


of

located in Government Lot 7 in the Southeast 1/4 of Section 26, Town 4 North, Range 16 East, Town of LaGrange, Walworth County, Wisconsin.

A parcel of land described in a Warranty Deed recorded June 3, 1997 in Vol. 647 on Page 6393 as Document No. 356273, as shown below:

Surveyed for: **Keefe Real Estate, Inc.**
751 Geneva Parkway
Lake Geneva, Wisconsin. 53147

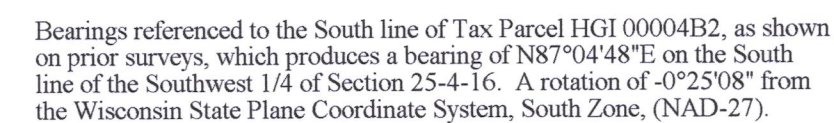

Coordinates are referenced to the Wisconsin State Plane Coordinate System, South Zone, (NAD-27).



- 1) This Plat of Survey is not certified unless signed and sealed in red ink.
- 2) This survey is subject to Wisconsin lien laws. This Plat of Survey is the notice of intent to file lien. Lien waiver required.
- 3) The Survey Date shown on this Plat of Survey is the completion date of the field work.

Copyright ©2021 by Olson Land Surveying, LLC.

All rights reserved. No part of this survey plat may be reproduced or transmitted in any form by any means - graphic, electronic, or mechanical, including photocopying, tracing, or information storage and retrieval systems - without permission in writing from Douglas G. Olson, Olson Land Surveying, LLC.

I hereby certify that I have surveyed the above described property in compliance with Chapter A-E 7 of the Wisconsin Administrative Code and that the map hereon is correct to the best of my professional knowledge and belief and shows the size and location of the property, its exterior boundaries, the location and dimensions of all visible structures thereon, boundary fences, apparent easements and roadways and visible encroachments, if any.

This survey is made for the exclusive use of the present owners of the property, and also those who purchase, mortgage or guarantee title thereto, within one year from the date hereof.

Douglas G. Olson
Wisconsin Professional Land Surveyor - 2093

South line of the Southwest 1/4 of Section 25-4-16
N87°04'48"E 2080.78'
Recorded as (N87°29'56"E 2080.67') State Plane

South 1/4 Corner
Section 25-4-16
(N. 284,423.24)
(E. 2,388,292.64)

Survey Date: September 7, 2021.
Revisions:

Scale in Feet
1" = 20'

0' 10' 20' 40' 60'

445 South Wisconsin Street | P.O. Box 322
Elkhorn, Wisconsin. 53121
Telephone: (262) 723-3434
Facsimile: (262) 723-8044
Email: doug@olsonsurveying.com
Website: www.olsonsurveying.com

OLSON
LAND SURVEYING, LLC
Rural | Residential | Commercial

Legend County Section Corner

●	Found	North
○	Found	South
●	Found	East
○	Found	West
●	Found Iron Pipe	W
○	Found Iron Rod	W
○	Set Iron Pipe, 1" dia.	Minutes
○	Set Iron Pipe, 1" dia.	Seconds
○	Set Mag Nail	In Distances
○	Set Mag Nail	Feet
○	Recorded Information	
⊗	Utility Pole	
⊗	Utility Pedestal	
⊗	Asphalt Surface	

Sheet 1 of 1 Sheets

Drawing Name:

Job Reference Number
2021.091

2021.091