LAND-MARK SURVEYING Mark L. Miritz

Wisconsin Professional Land Surveyor S-2582

HME-3


N9330 Knuteson Drive Whitewater, WI 53190 Phone:(262)949-1239 MARKMIRITZ@ LAND-MARKSURVEYING.COM

PLAT OF SURVEY

LOT 3, MERRILL PARK SUBDIVISION, LOCATED IN THE SOUTHWEST 1/4 OF SECTION 26, TOWN 4 NORTH, RANGE 16 EAST, LAGRANGE TOWNSHIP, WALWORTH COUNTY, WISCONSIN.

OWNER: PILLSBURY TRUST
23 WILLOW CREST ROAD
OAK BROOK, IL 60523

SEE BRENNAN SISTERS DESIGN FOR COMPLETE DETAILS
SHANNON BRENNAN-SCHOPP
ELKHORN, WI
262-903-1266

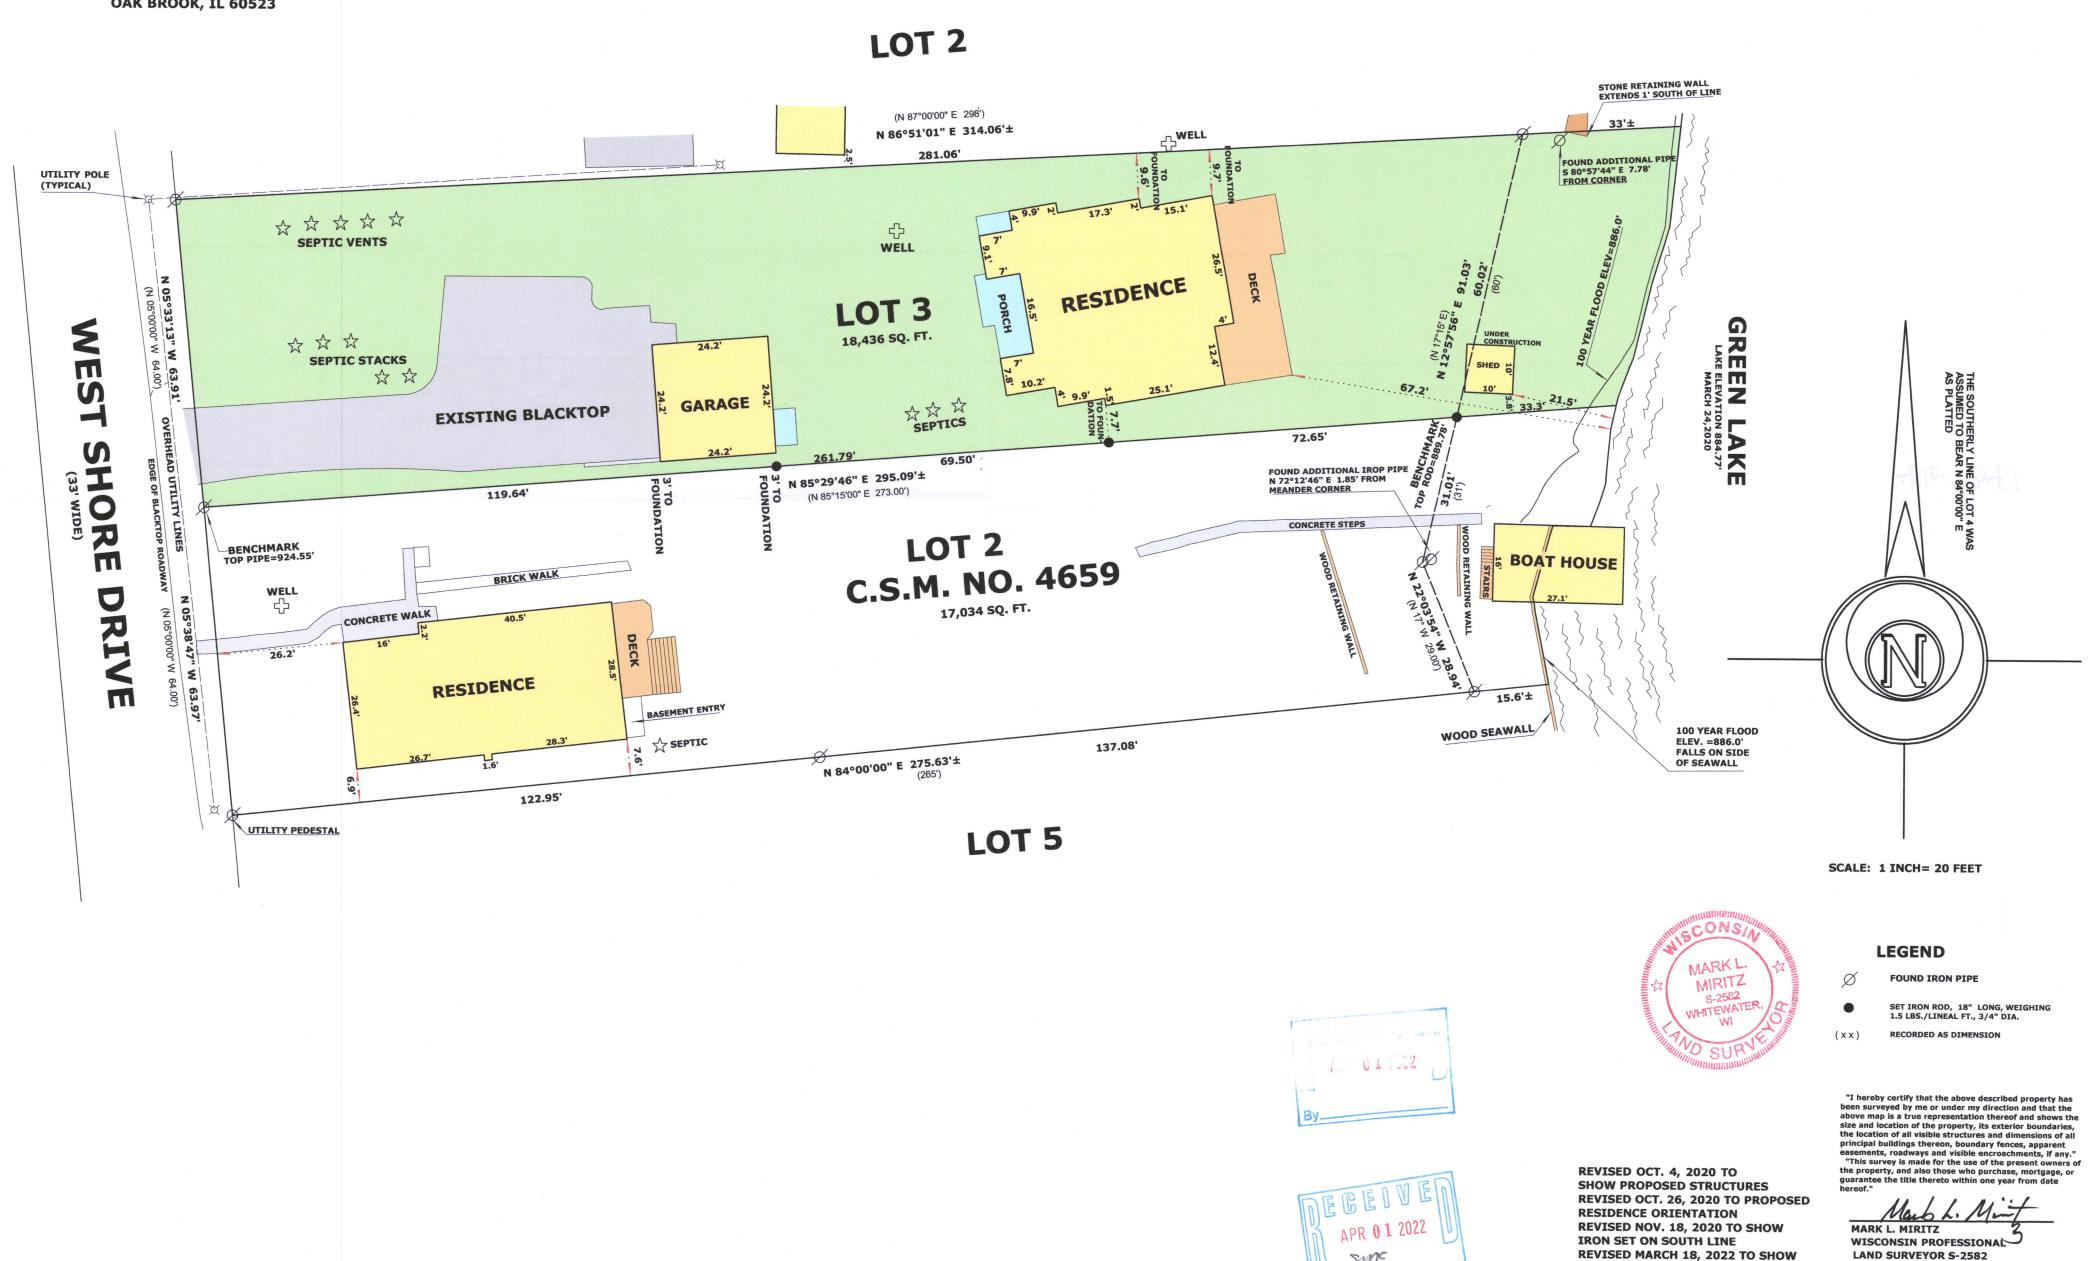

DATE: MAY 16, 2014 JOB NO. __14.419

BUILDINGS "AS BUILT"