
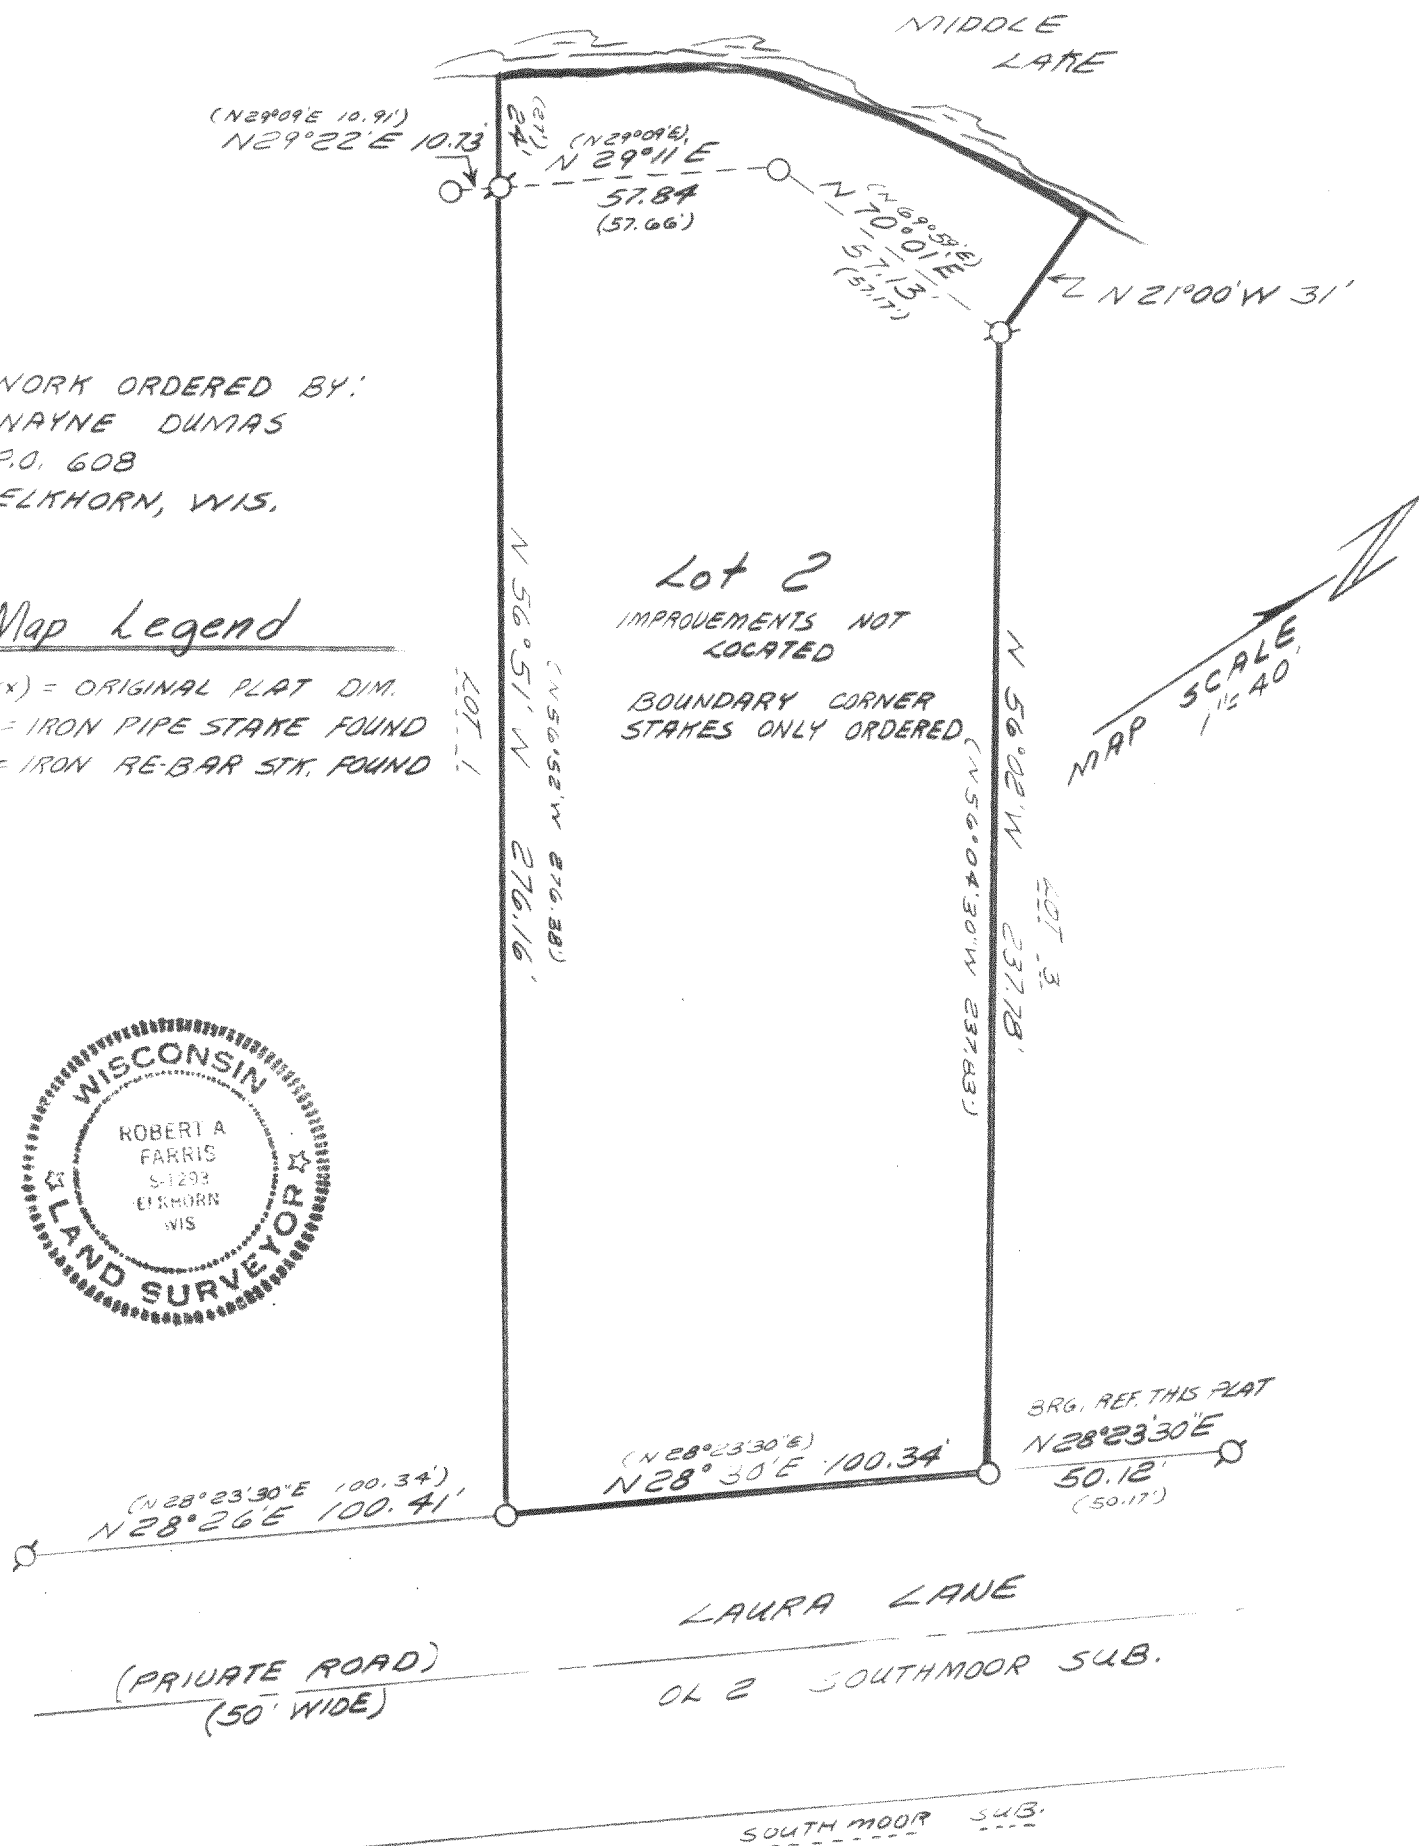


WORK ORDERED BY:
WAYNE DUMAS
P.O. 608
ELKHORN, WIS.

Map Legend

(xxx) = ORIGINAL PLAT DIM.
○ = IRON PIPE STAKE FOUND
⊗ = IRON RE-BAR STK. FOUND

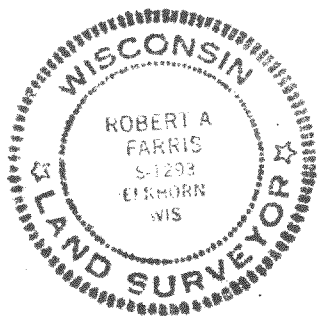

Plat of Survey of Lot 2 of Westmoor Subdivision in SW 1/4 Sec. 25, T. 4N, R. 16E, Walworth Co., Wis.

I HEREBY CERTIFY THAT THIS PLAT IS A TRUE AND ACCURATE REPRESENTATION OF THE LOT LINES TO THE BEST OF MY PROFESSIONAL KNOWLEDGE AND BELIEF.

Robert A. Farris

ROBERT A. FARRIS RLS

DATED 9/25/84

FARRIS, HANSEN & ASSOC., INC.
ELKHORN, WISCONSIN
PROJECT NO. 2314