


Plat of Survey

of

Lot 1 of Certified Survey Map No. 5074,



recorded December 16, 2022 as Document Number 1072875 and located in Government Lot 8 in the Northeast 1/4 of Section 26, Town 4 North, Range 16 East, Town of LaGrange, Walworth County, Wisconsin.

Surveyed for: **Bill Sattler**
5330 West Hutchinson Street
Chicago, Illinois. 60641

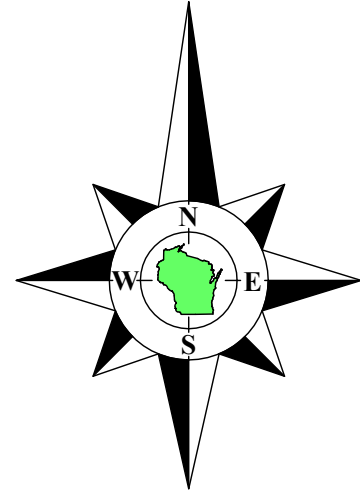

Bearings referenced to Certified Survey Map No. 5074. A rotation of -1°21'09" from the Wisconsin State Plane Coordinate System, South Zone, (NAD-27).

Coordinates are referenced to the Wisconsin State Plane Coordinate System, South Zone, (NAD-27).

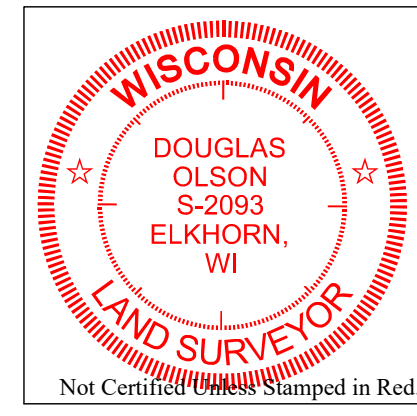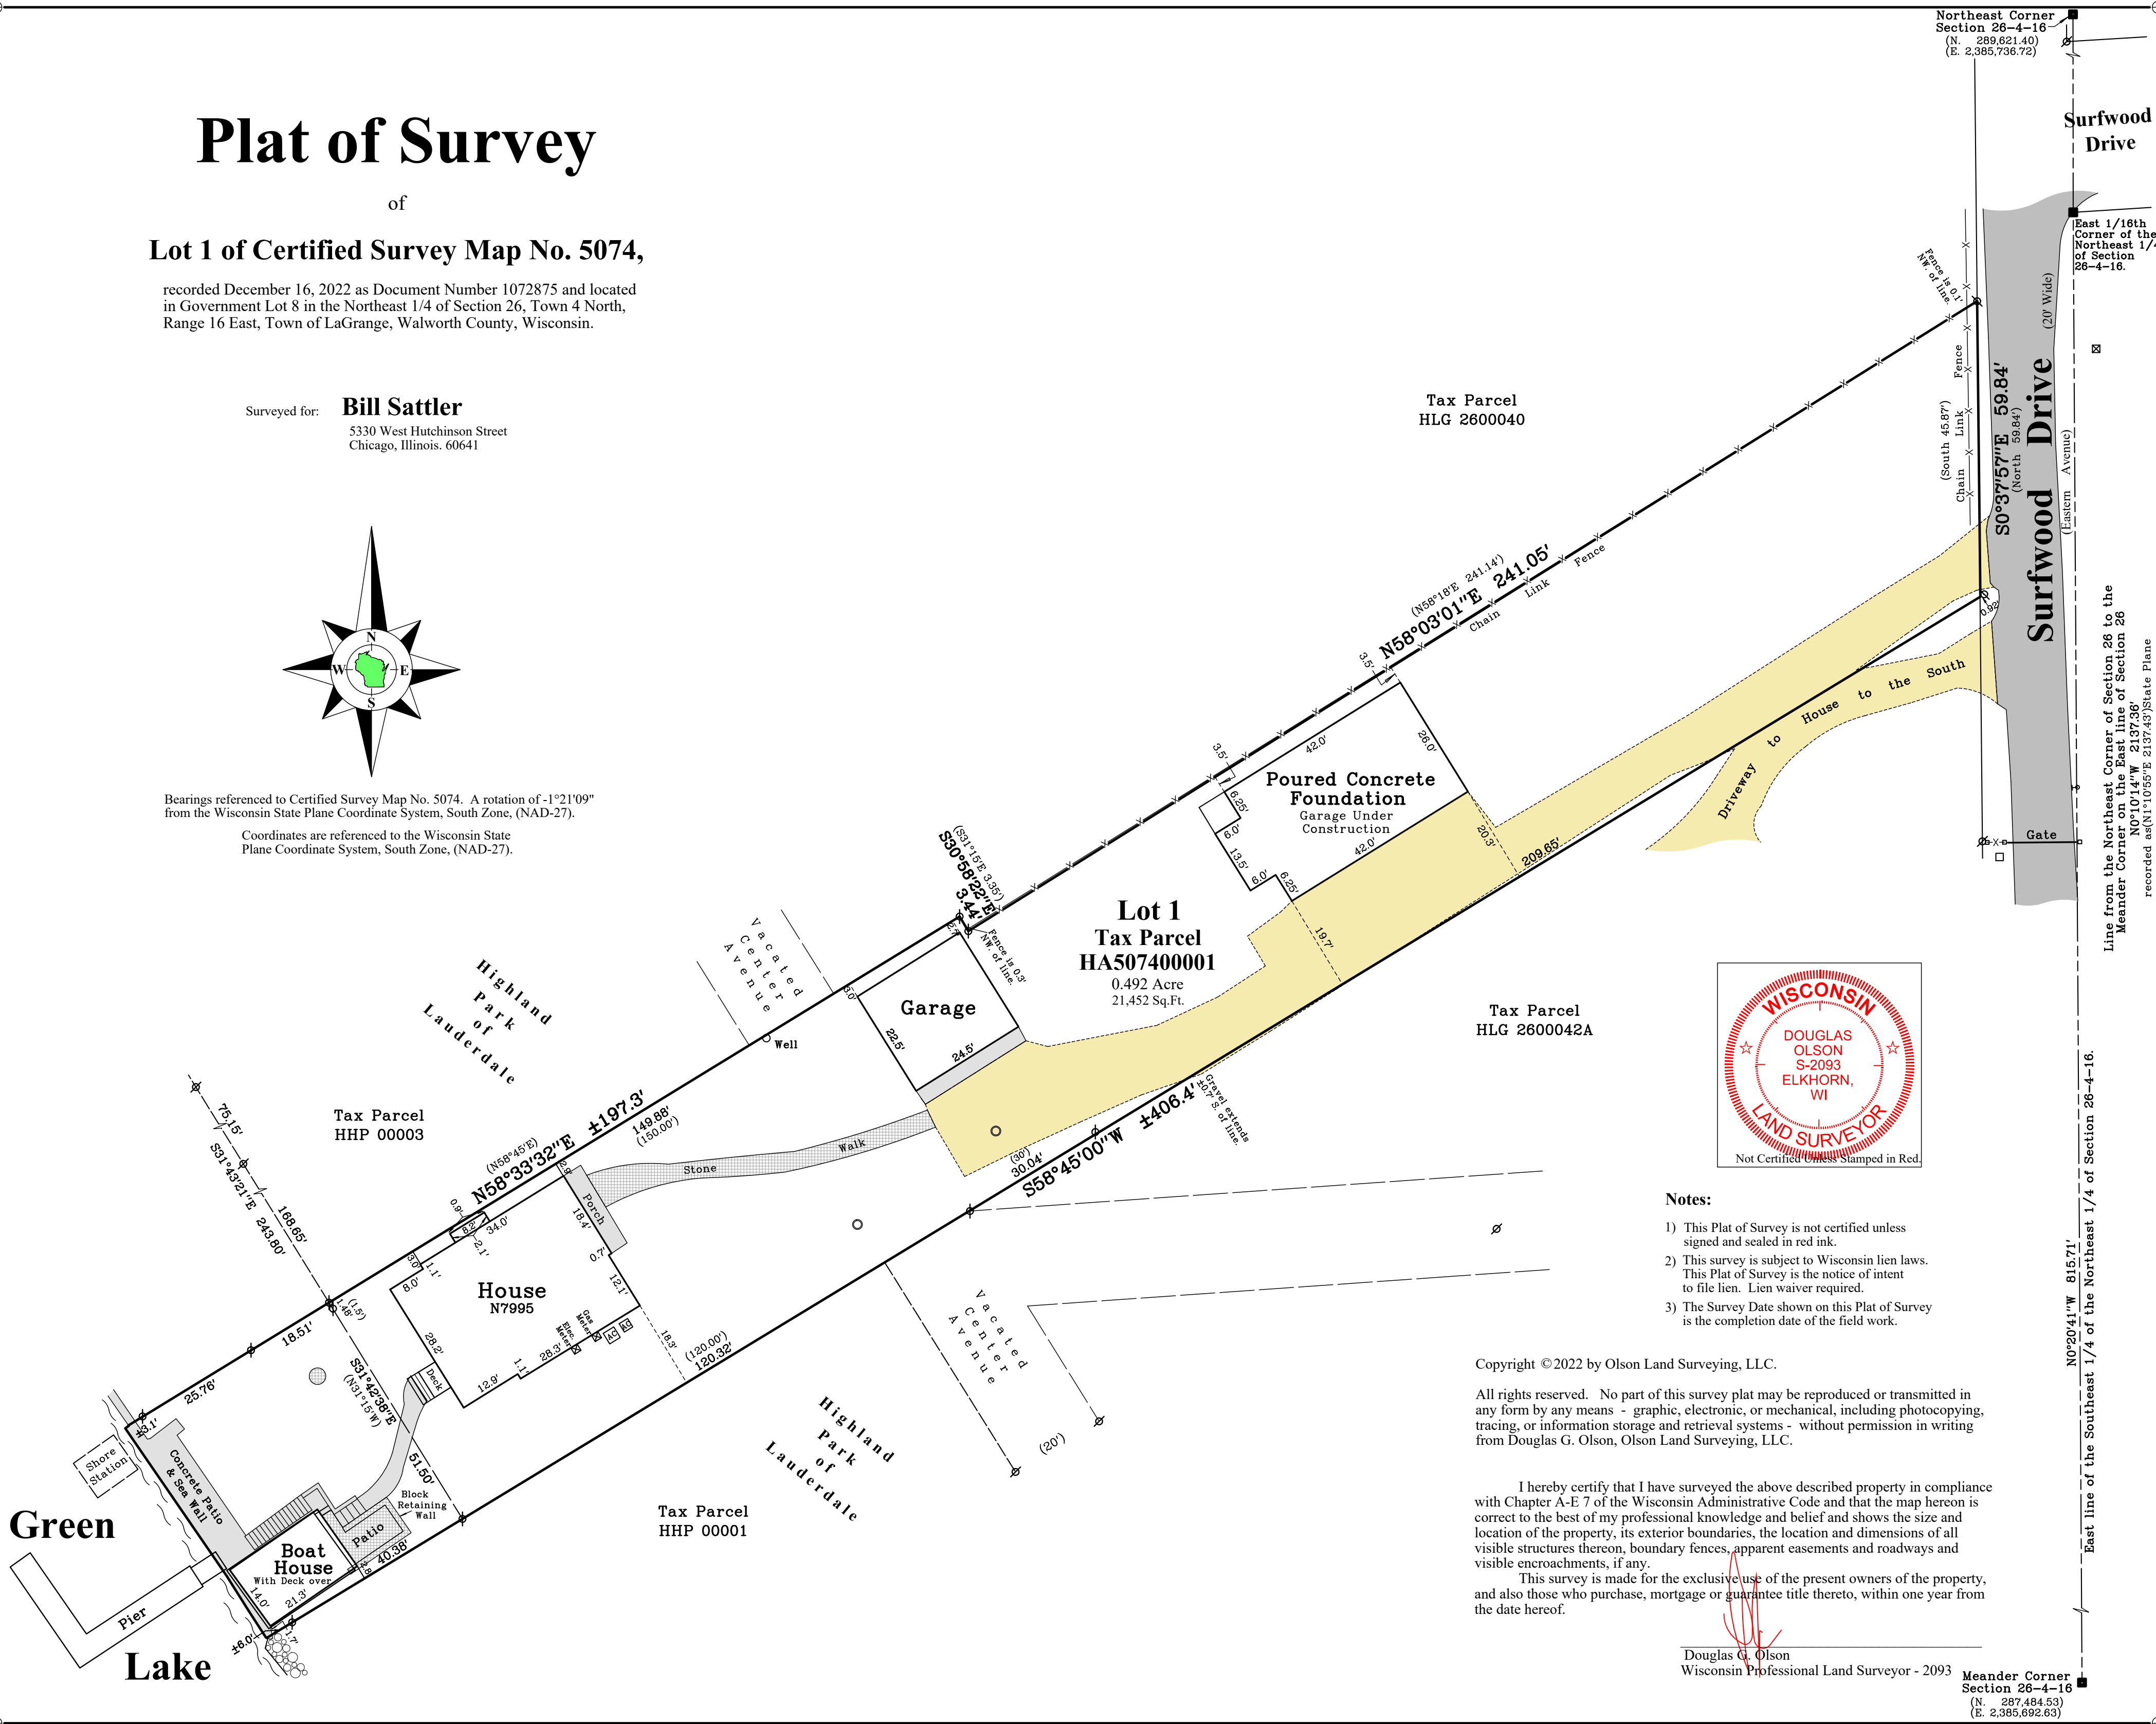

- Notes:**
- 1) This Plat of Survey is not certified unless signed and sealed in red ink.
 - 2) This survey is subject to Wisconsin lien laws. This Plat of Survey is the notice of intent to file lien. Lien waiver required.
 - 3) The Survey Date shown on this Plat of Survey is the completion date of the field work.


Copyright © 2022 by Olson Land Surveying, LLC.
All rights reserved. No part of this survey plat may be reproduced or transmitted in any form by any means - graphic, electronic, or mechanical, including photocopying, tracing, or information storage and retrieval systems - without permission in writing from Douglas G. Olson, Olson Land Surveying, LLC.

I hereby certify that I have surveyed the above described property in compliance with Chapter A-E 7 of the Wisconsin Administrative Code and that the map hereon is correct to the best of my professional knowledge and belief and shows the size and location of the property, its exterior boundaries, the location and dimensions of all visible structures thereon, boundary fences, apparent easements and roadways and visible encroachments, if any.
This survey is made for the exclusive use of the present owners of the property, and also those who purchase, mortgage or guarantee title thereto, within one year from the date hereof.


Douglas G. Olson
Wisconsin Professional Land Surveyor - 2093

Meander Corner
Section 26-4-16
(N. 287,484.53)
(E. 2,385,692.63)

Survey Date: September 29, 2022.
Revisions:
No. 1 - Proposed Garage
No. 2 - Recorded CSM
No. 3 - As Shaded
No. 4 - Poured Concrete Foundation

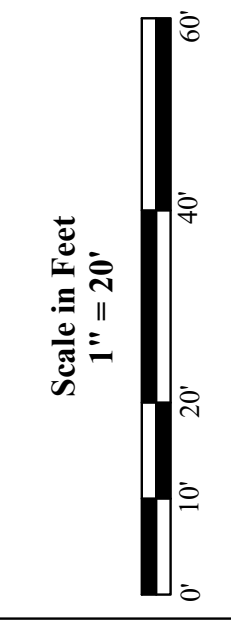

45 South Wisconsin Street | P.O. Box 322
Elkhorn, Wisconsin, 53121
Telephone: (262) 723-3434
Facsimile: (262) 723-8044
Email: doug@olsonsurveying.com
Website: www.olsonsurveying.com

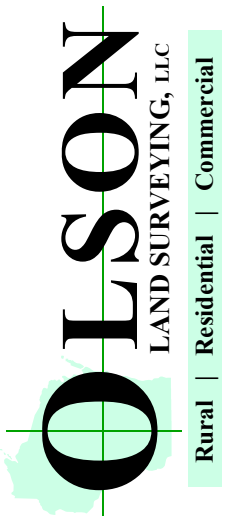

Legend of Symbols & Abbreviations

North	Section Corner
South	Section Corner
East	Section Corner
West	Section Corner
Found	Found
Reinforced	Reinforced
Concrete	Concrete
Asphalt	Asphalt
Concrete	Concrete
Brick	Brick
Pavers	Pavers
Wood	Wood
Set	Set
Stake	Stake
Distances	Distances
Minutes	Minutes
Seconds	Seconds
Feet	Feet
Inches	Inches

Sheet 1 of 1 Sheets
Drawing Name:
Job Reference Number
2022.102
2022.102