


PLAT OF SURVEY

CHARLES H. STRAND & ASSOCIATES
Fort Atkinson, Wisconsin

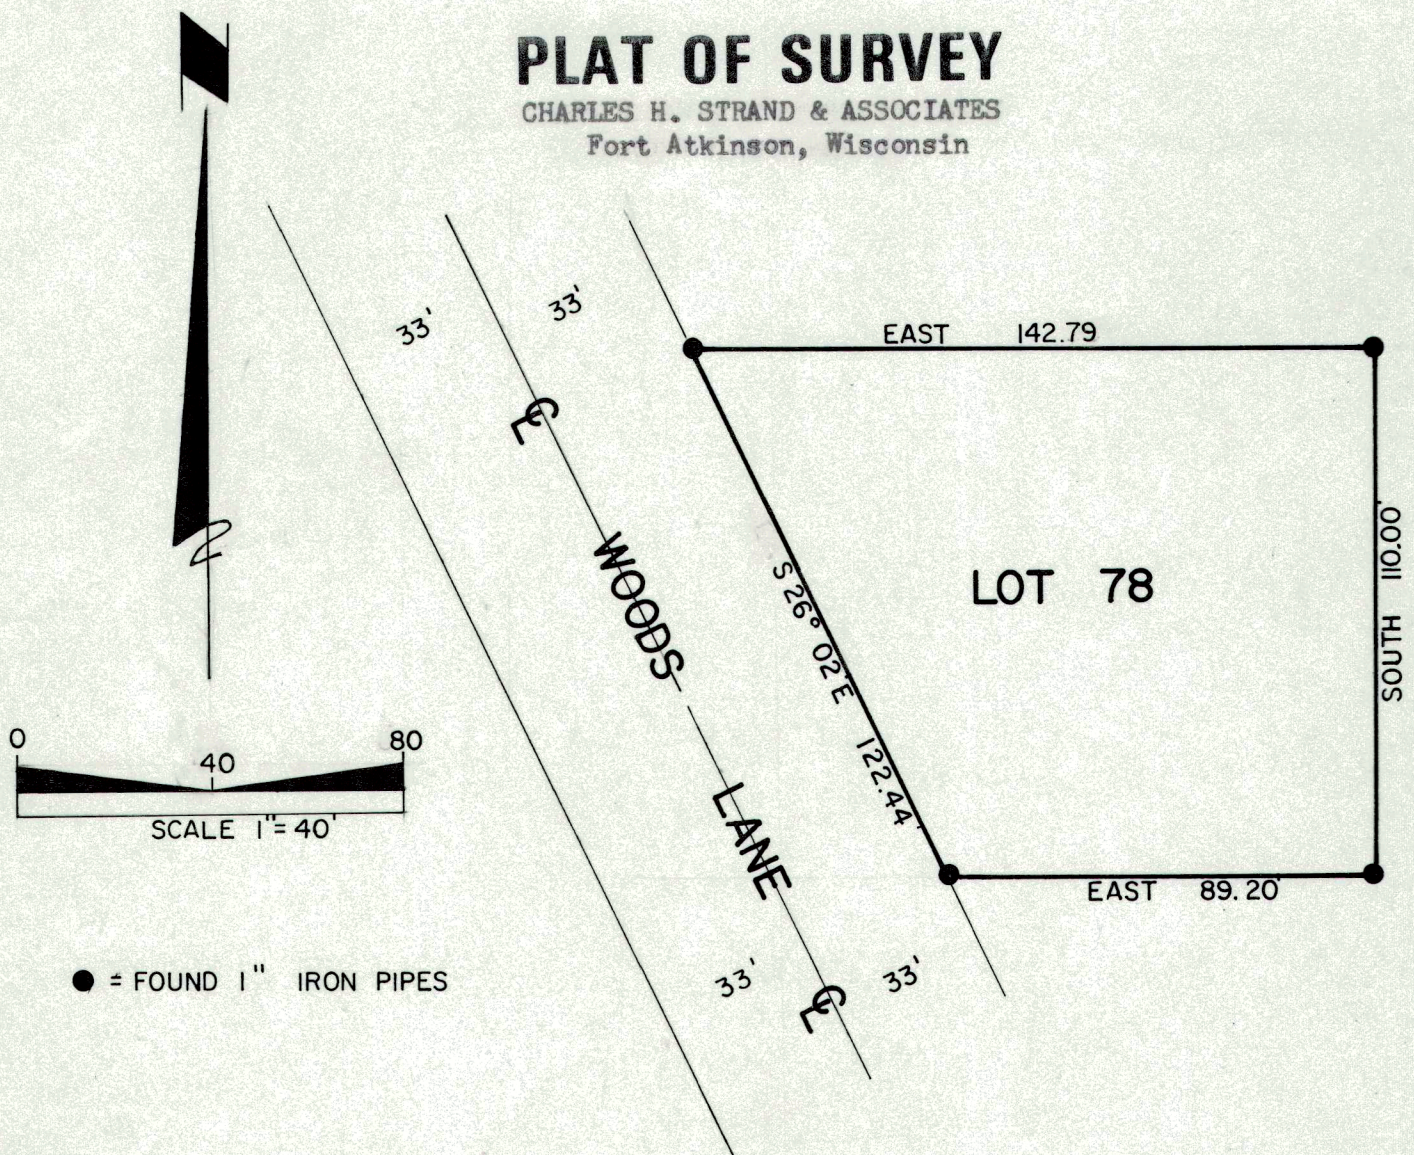

DESCRIPTION:

Lot 78 Bubbling Springs Subdivision, Section 34, T 4 N, R 16 E, Town of Lagrange, Walworth County, Wisconsin.


SURVEYOR CERTIFICATE:

I hereby certify that I have surveyed the property described above and that this plat is a correct representation of the lot lines and demensions.

Date;

August 19, 1974

Charles H. Strand
Charles H. Strand
Wisconsin Land Surveyor S-11120

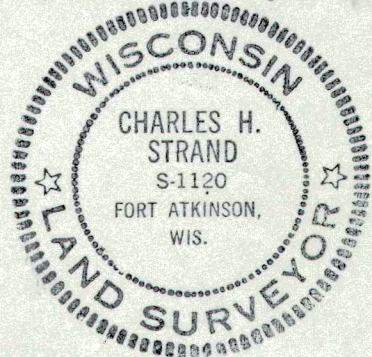

SURVEYED FOR: Jerry Behm

DATE: August 15, 1974

DWG. NO. 74S-86

SHEET 1 OF 1

HBSI-47

416-3490