


**D.D. COOPER & CO. INC.**

Route 4 Box 508A  
Elkhorn WI 53121  
Phone-414-723-6265


PLAT OF SURVEY OF

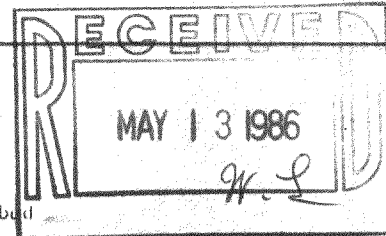

Certified Survey No. 845 recorded in the Walworth County Register of Deeds Office on September 27, 1978 in Volume 4 of Certified Surveys at Page 30 as Document No. 38779, which parcel is also described as follows: A parcel of land located in the Southeast 1/4 of Section 32, Town 4 North, Range 16 East, Walworth County, Wisconsin, described as follows: Commencing at the Southeast corner of said Section 32; thence West 2647.57 feet to the Southwest corner of said Southeast 1/4 as fenced and the place of beginning; thence North 0°06'00" West along the West line of said Southeast 1/4 as fenced 287.20 feet; thence East 455.00 feet; thence South 0°06'00" East 287.20 feet; thence West 455.00 feet to the place of beginning containing 3.00 acres of land.

ALSO


A parcel of land located in the Southwest 1/4 of the Southeast 1/4 of Section 32, Town 4 North, Range 16 East, Walworth County, Wisconsin, described as follows: Beginning on the South line of said Southeast 1/4 at the Southeast corner of Certified Survey Map No. 845, recorded in Volume 4 of Certified Surveys on Page 30, in the Office of the Register of Deeds; thence North 0°16' West along the East line of said Certified Survey Map No. 845, 151.00 feet; thence East parallel with the South line of said Southeast 1/4, 17.50 feet; thence South 0°06' East 151.00 feet; thence West along the South line of said Southeast 1/4, 17.50 feet to the place of beginning.

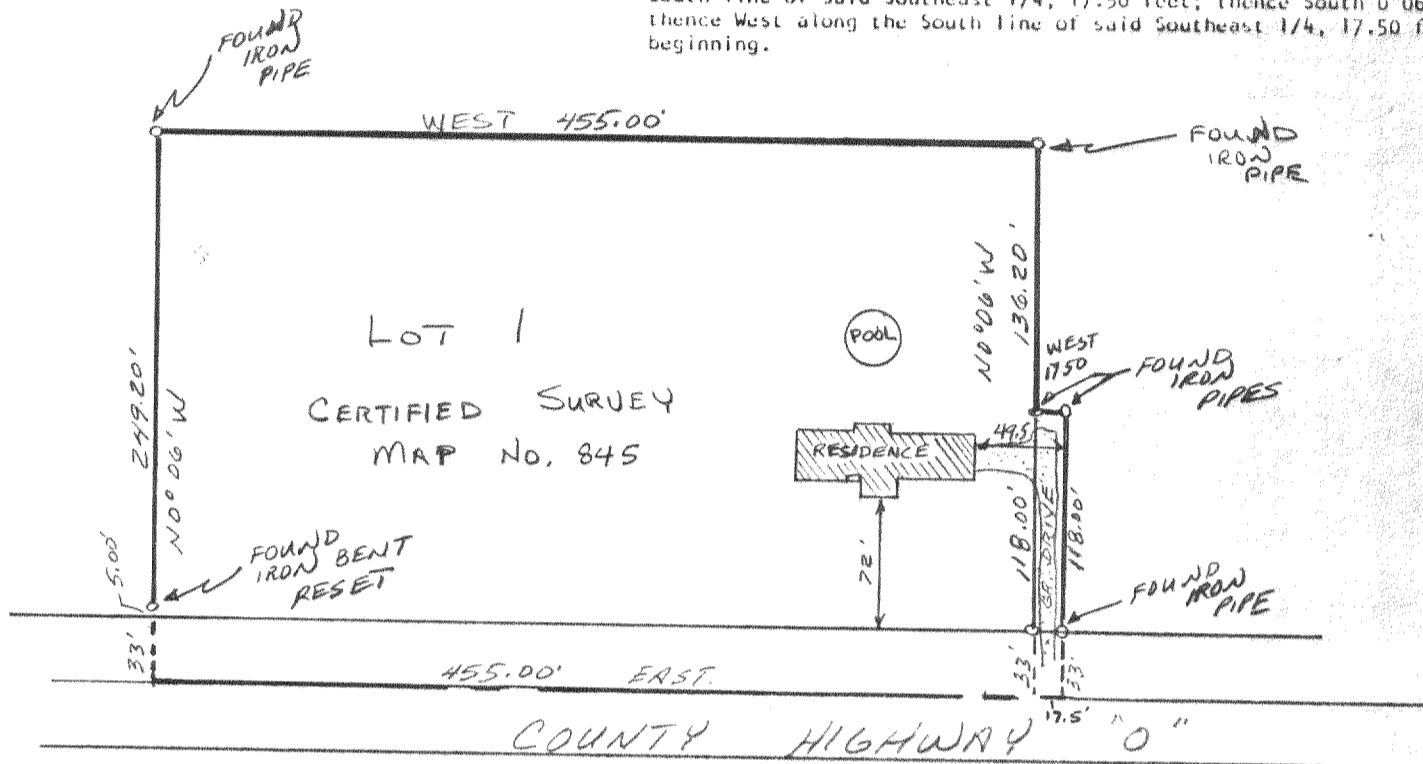

SCALE 1"=100'

SURVEY ORDERED BY CENTURY 21 WHITEWATER

BEARING REFERENCE  
NORTHERLY LINE OF PARCEL ASSUMED TO BEAR  
EAST-WEST AS RECORDED

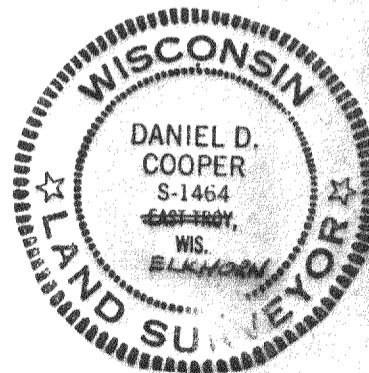

I, DANIEL D. COOPER, REGISTERED SURVEYOR, DO HEREBY CERTIFY THAT I HAVE SURVEYED THE PROPERTY DESCRIBED HEREON AND THAT THE MAP SHOWN HEREON IS A TRUE AND ACCURATE REPRESENTATION THEREOF TO THE BEST OF MY PROFESSIONAL KNOWLEDGE AND BELIEF.

DATED THIS 5 DAY OF MAY, 1986

Daniel D. Cooper  
DANIEL D. COOPER, RLS NO. S-1464

416-369

~~416-369~~-C

DRAWING NO. 2193-4-39

LAGRANGE

TAX PARCEL

HA 845 00001