


RECEIVED
AUG 19 1986
JL

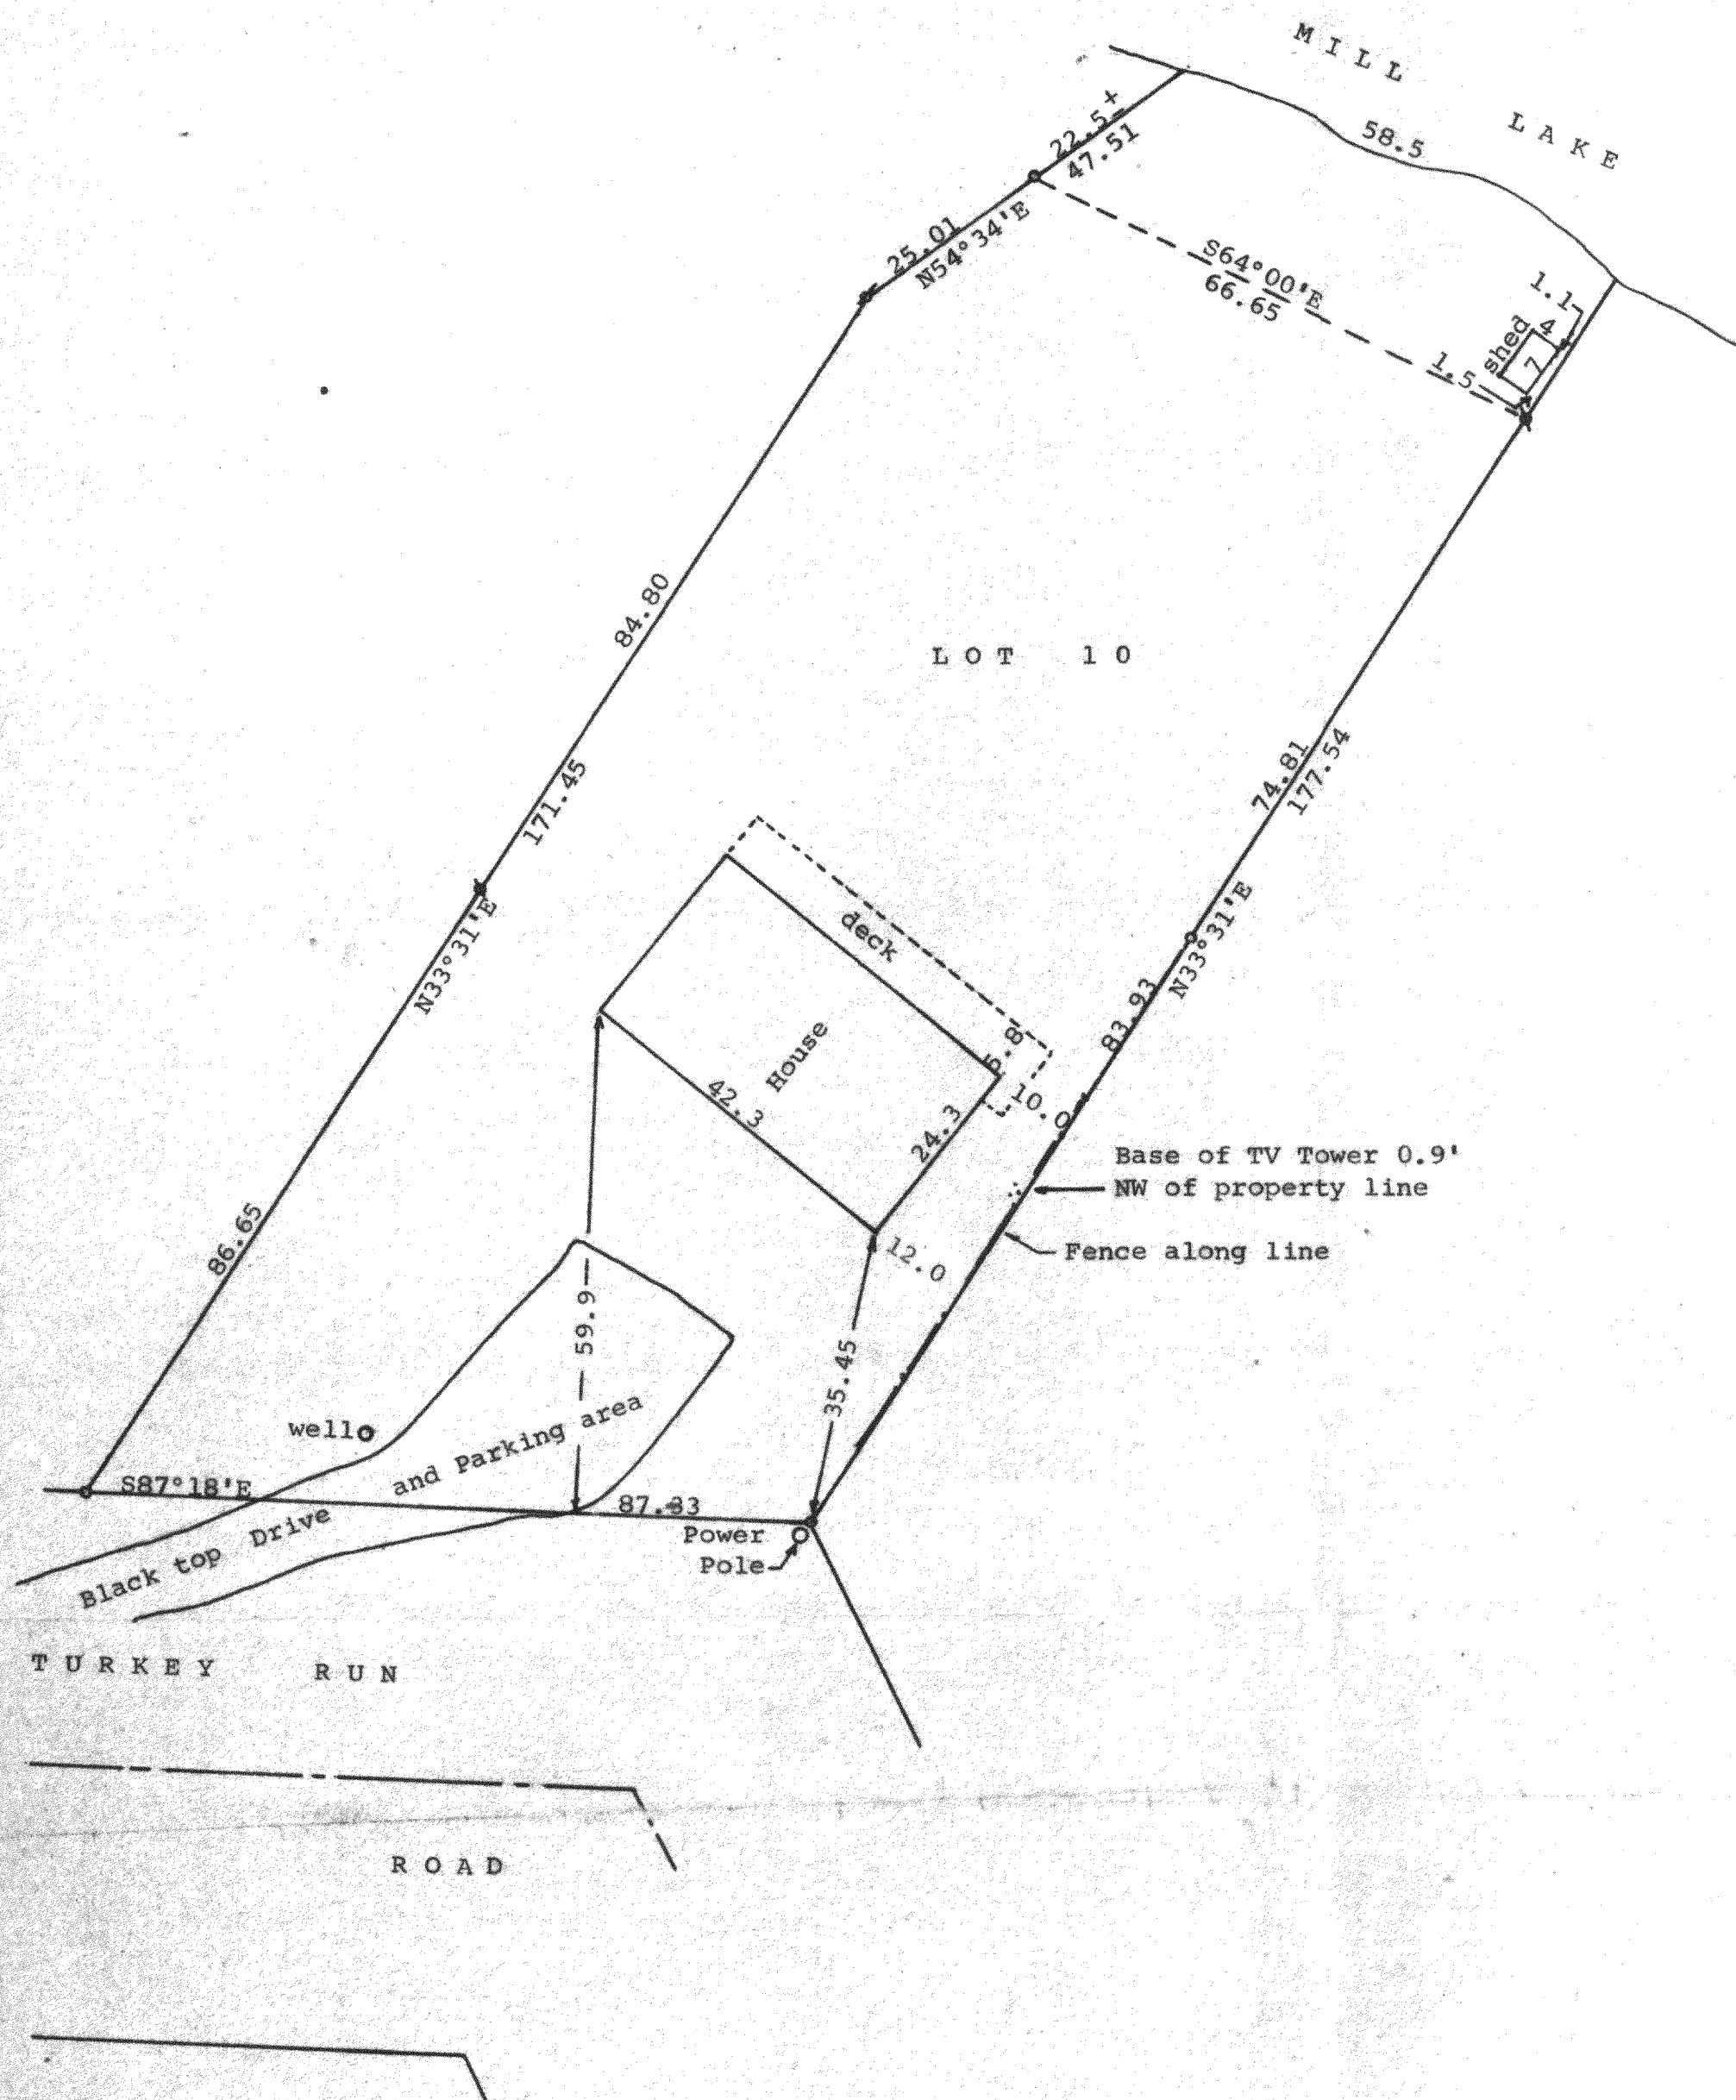

○ = 1" Iron Pipe Found
 ∅ = 3/4" Iron Pipe Found
 ≡ = 1 1/4" Iron Pipe Found

Recertification ordered by: Modern Realty
Elkhorn, WI 53121

George T. Dunham
George T. Dunham, Surveyor