
of

All of Lot 9 and Lot 10 except the Southwesterly 24 feet of said Lot 10, in Block 2 of Green Lake Park Subdivision, located in Section 26, Town 4 North, Range 16 East, Walworth County, Wisconsin.

a parcel of land more particularly described as follows: Commence at the Northwest Corner of Block 4 of said Green Lake Park Subdivision: thence S 31^46' W. along the East line of a public road, 100.50 feet to the Point of Beginning; thence S  $65^\circ15'$  E 34.00 feet; thence N 31^46' E 46.65 feet; thence S  $58^\circ42'42''$  E 35.75 feet; thence S 31^46' N 55.00 feet; thence N  $65^\circ15'$  W 70.00 feet to the East line of said public road; thence 31^46' E, along said East line,12.50 feet to the Point of

Parcel contains 0.056 acres of land, more or less and is listed under Tax key # GP-00028 at the Walworth County Courthouse.

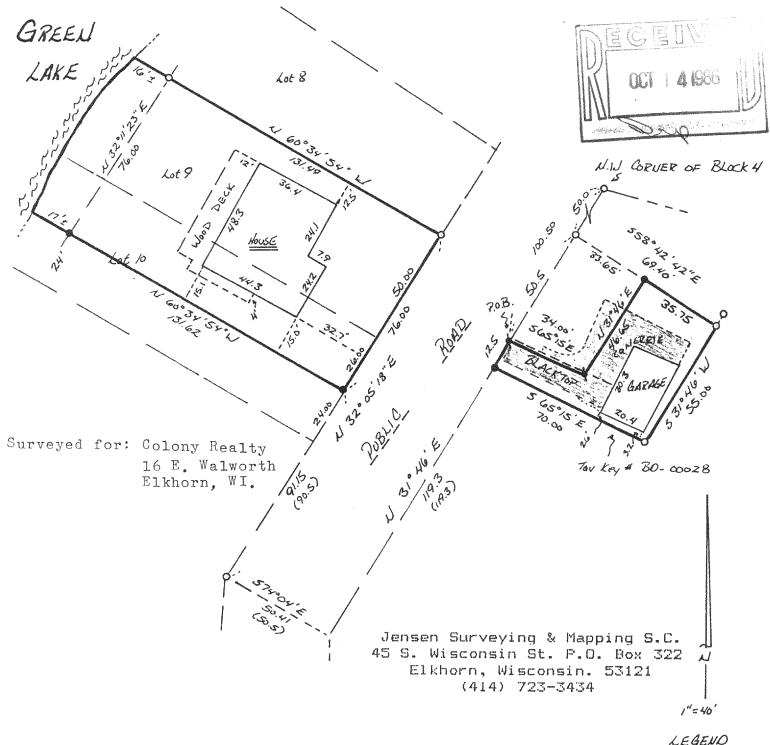

LEGENO

0 ~ FOUND IRON PIPE ● ~ SET 3/4" /ROW ROD

Y-SET P.K. NAIL

Note: This survey plat is not certified unless signed and sealed in red ink.

I. Thomas P.A. Jensen, Wisconsin Registered Land Surveyor, AUGOST 22,1986 do hereby certify that this survey was performed by me, or under my direction, in full compliance with the owner's/agent's instructions and chapter A-E 5 of the Wisconsin Administrative Code "Minimum Standards For Property Surveys"; and that this map is an accurate representation thereof to the best of my knowledge and belief.