


ABERNATHY and ASSOCIATES

Kenneth B. Abernathy Jr.

Wisconsin Registered Land Surveyor S-1594

Rt. 3, Box 273
 Elkhorn, Wisconsin 53121
 Phone: (414) 723-4260 (office)
 (414) 723-4813 (residence)

PLAT OF SURVEY

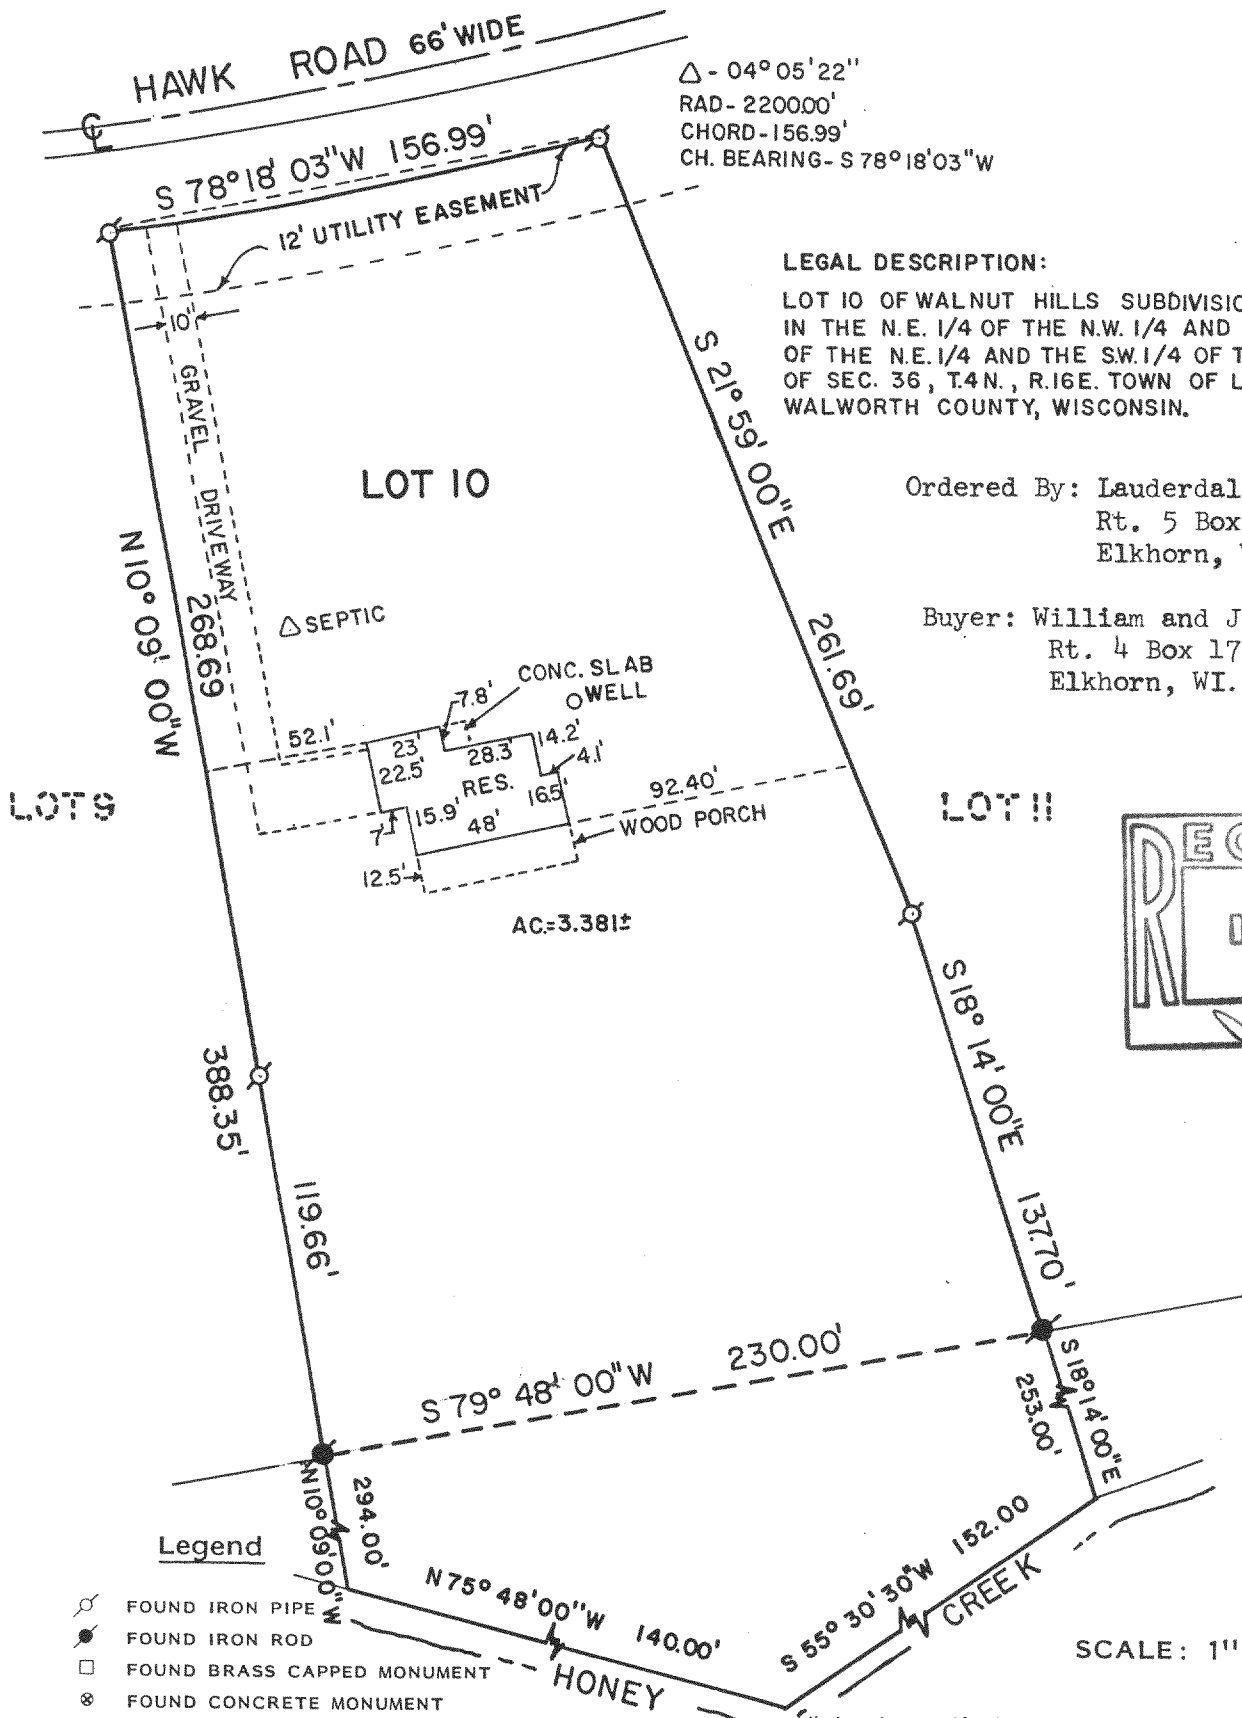


Δ - 04° 05' 22"
 RAD - 220000'
 CHORD - 156.99'
 CH. BEARING - S 78° 18' 03" W

LEGAL DESCRIPTION:

LOT 10 OF WALNUT HILLS SUBDIVISION, LOCATED IN THE N.E. 1/4 OF THE N.W. 1/4 AND THE NW 1/4 OF THE N.E. 1/4 AND THE SW. 1/4 OF THE N.E. 1/4 OF SEC. 36, T.4N., R.16E. TOWN OF LAGRANGE, WALWORTH COUNTY, WISCONSIN.

Ordered By: Lauderdale Lakes Realty
 Rt. 5 Box 152 C
 Elkhorn, WI. 53121

Buyer: William and Janet Kornhoff
 Rt. 4 Box 174
 Elkhorn, WI. 53121

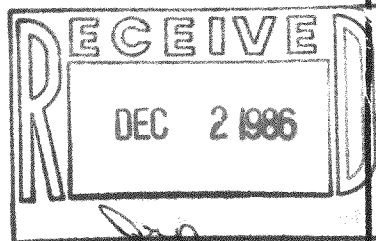

LOT 9

LOT 11

Legend

- FOUND IRON PIPE
- FOUND IRON ROD
- FOUND BRASS CAPPED MONUMENT
- ⊗ FOUND CONCRETE MONUMENT
- + CHISEL CUT IN CONCRETE
- SET IRON ROD, 24" LONG, WEIGHING 1.5 LBS./LINEAL FT., 3/4" DIA.
- SET IRON ROD, 30" LONG, WEIGHING 4.5 LBS./LINEAL FT., 1-11/16" DIA.
- (xx) RECORDED AS DIMENSION
- x-x- EXISTING FENCE



"I hereby certify that I have surveyed the above described property and that the above map is a true representation thereof and shows the size and location of the property, its exterior boundaries, the location of all visible structures and dimensions of all principal buildings thereon, boundary fences, apparent easements, roadways and visible encroachments, if any."
 "This survey is made for the use of the present owners of the property, and also those who purchase, mortgage, or guarantee the title thereto within one year from date hereof."

Kenneth B. Abernathy, Jr.

KENNETH B. ABERNATHY, JR.
 WISCONSIN REGISTERED LAND SURVEYOR,
 S-1594

Date: 11/18/86 Job No. 1105



SCALE: 1" = 60 FEET