
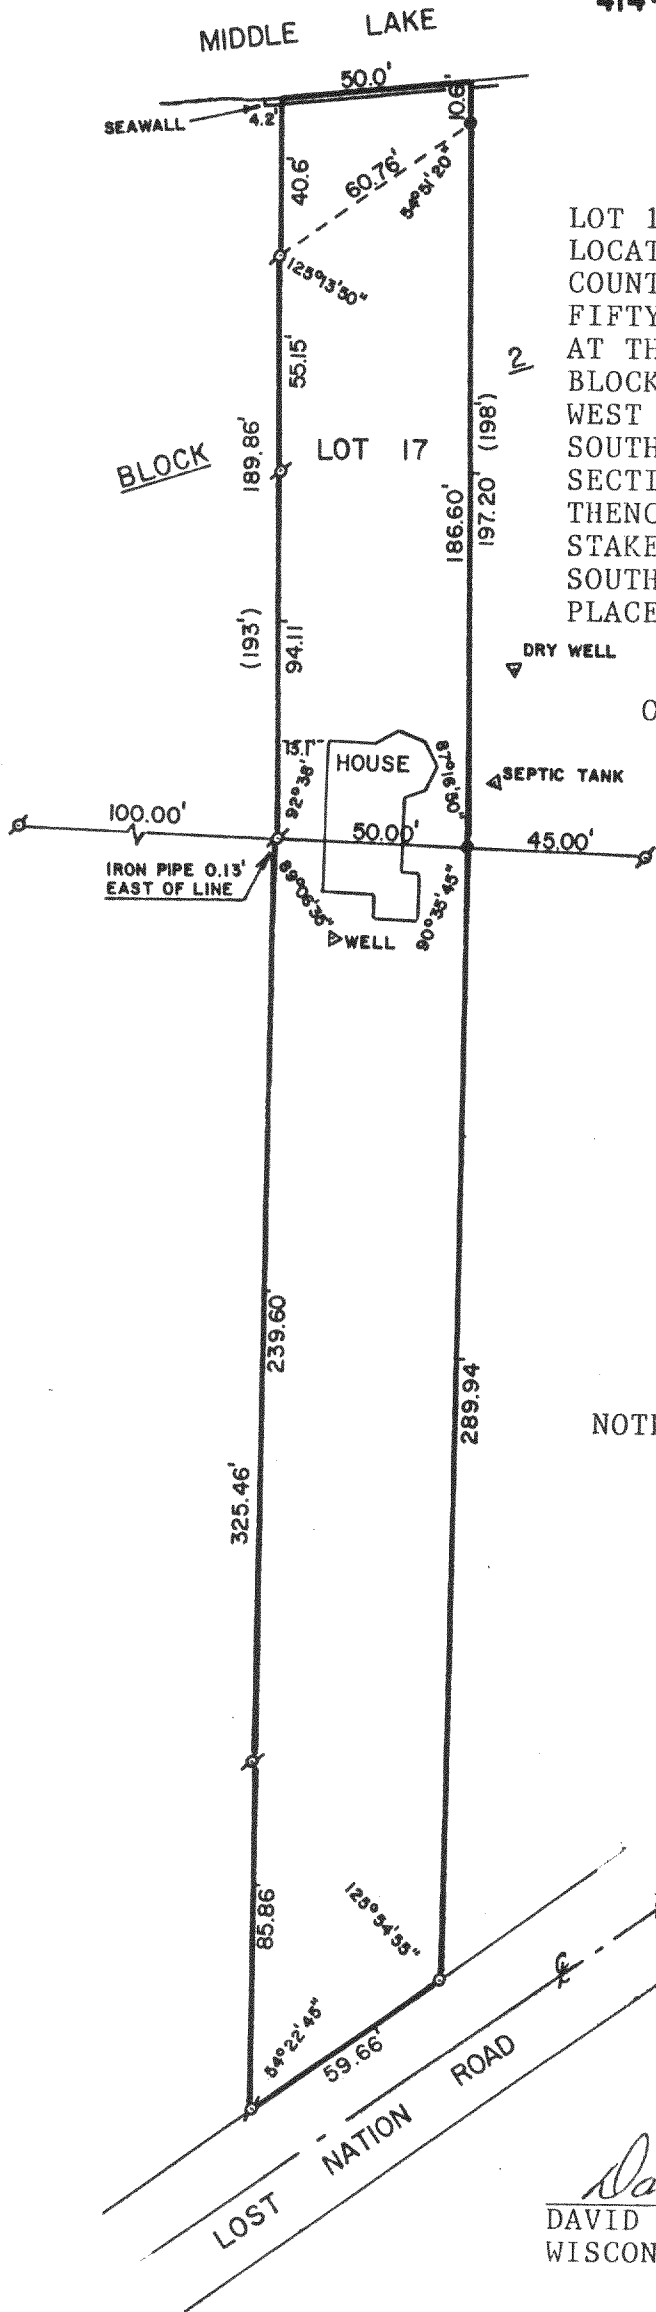


ABELL
SURVEYING & MAPPING
 DELAVAN, WISCONSIN 53115
 414-728-6737

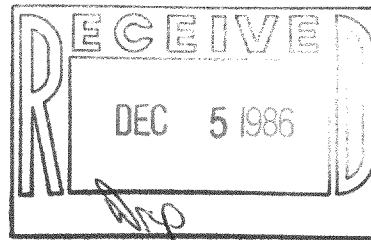

PLAT OF SURVEY OF

LOT 17, BLOCK 2, THANSLAND SUBDIVISION,
 LOCATED IN SECTION 35, T4N,R16E, WALWORTH
 COUNTY, WISCONSIN, AND ALSO THE MIDDLE
 FIFTY FEET OF THE FOLLOWING: COMMENCING
 AT THE SOUTHEAST CORNER OF LOT 16 OF SAID
 BLOCK; THENCE WEST 145 FEET TO THE SOUTH-
 WEST CORNER OF LOT 18 OF SAID BLOCK; THENCE
 SOUTH PARALLEL WITH THE NORTH-SOUTH 1/4
 SECTION LINE 359 FEET TO AN IRON STAKE;
 THENCE NORTH EASTERLY 179 FEET TO AN IRON
 STAKE; THENCE NORTH PARALLEL WITH THE NORTH-
 SOUTH 1/4 SECTION LINE 254 FEET TO THE
 PLACE OF BEGINNING.

ORDERED BY: LANHAM REALTY
 20 SOUTH WASHINGTON
 ELKHORN, WI 53121



SCALE - 1"=50'

LEGEND

- ♠ - IRON PIPE FOUND
- - IRON PIPE SET
- - 3/4" DIA. IRON ROD SET
- () - RECORDED AS

NOTE: THE DRY WELL AND SEPTIC TANK FOR LOT 17 FALLS ON LOT 16.



I, DAVID F. ABELL, DO HEREBY CERTIFY
 THAT I HAVE SURVEYED THE PROPERTY
 HEREON DESCRIBED ACCORDING TO THE
 OFFICIAL RECORDS, AND THAT THE PLAT
 HEREON IS A CORRECT REPRESENTATION
 OF THE PROPERTY LINES TO THE BEST OF
 MY KNOWLEDGE AND BELIEF.

David F. Abell
 DAVID F. ABELL
 WISCONSIN REGISTERED LAND SURVEYOR, S-1596

August 7, 1986
 DATE JOB NUMBER - 86032