


of  
Lots 53 and 54 of the First Addition to Bubbling Springs  
Subdivision, located in Sections 34 and 35, Town 4 North,  
Range 16 East, Walworth County, Wisconsin.

Copyright © 1987 by Jensen Surveying & Mapping S.C.


All rights reserved. No part of this survey plat may be reproduced or transmitted in any form by any means - graphic, electronic, or mechanical, including photocopying, tracing, or information storage and retrieval systems - without permission in writing from Thomas & Jensen, Land Surveying & Mapping S.C.

Prepared by:

SCALE :
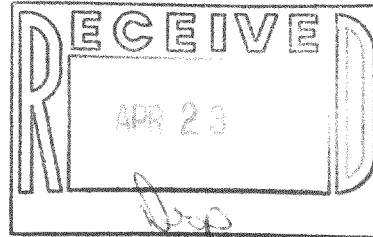
$$1'' = 50'$$


MIDDLE  
LAKE

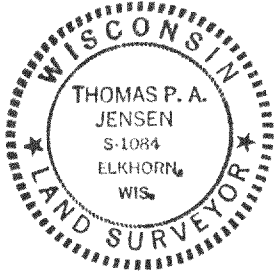

I certify that the property described above has been inspected under my responsible direction and supervision and that the above map is an accurate representation of the property and the location of all visible structural improvements, if any.

Date: APR 2, 37

Thomas P.A. Jensen R.L.S. 1084 1987.015

HBS 1-22, 23

416-430