

MORTGAGE INSPECTION

of
Lots 53 and 54 of the First Addition to Bubbling Springs
Subdivision, located in Sections 34 and 35, Town 4 North,
Range 16 East, Walworth County, Wisconsin.


NOTE: In accordance with A-E 5.01 (1)(b) this inspection has been
exempted from the requirements of A-E 5.01, Minimum Standards for
Property Surveys. Lot dimensions are shown as recorded on the
legal description, Subdivision Plat, or on surveys of record.
These dimensions were not necessarily verified in the field and
no lot stakes were set in the course of this inspection. The
legal description is shown as previously recorded or as provided
by the person ordering this inspection. THIS INSPECTION DOES NOT
CONSTITUTE A COMPLETE PROPERTY SURVEY AND CANNOT BE RELIED ON AS
SUCH.

Prepared for: Lomas & Nettleton
Mortgage
4811 South 76th St.
Milwaukee, WI 53220

Prepared by:
Jensen Surveying & Mapping S.C.
45 S. Wisconsin St. P.O. Box 322
Elkhorn, Wisconsin. 53121
(414) 723-3434



Copyright © 1987 by Jensen Surveying & Mapping S.C.

All rights reserved. No part of this survey plat may be
reproduced or transmitted in any form by any means - graphic,
electronic, or mechanical, including photocopying, tracing, or
information storage and retrieval systems - without permission in
writing from Thomas P. A. Jensen, Jensen Surveying & Mapping S.C.

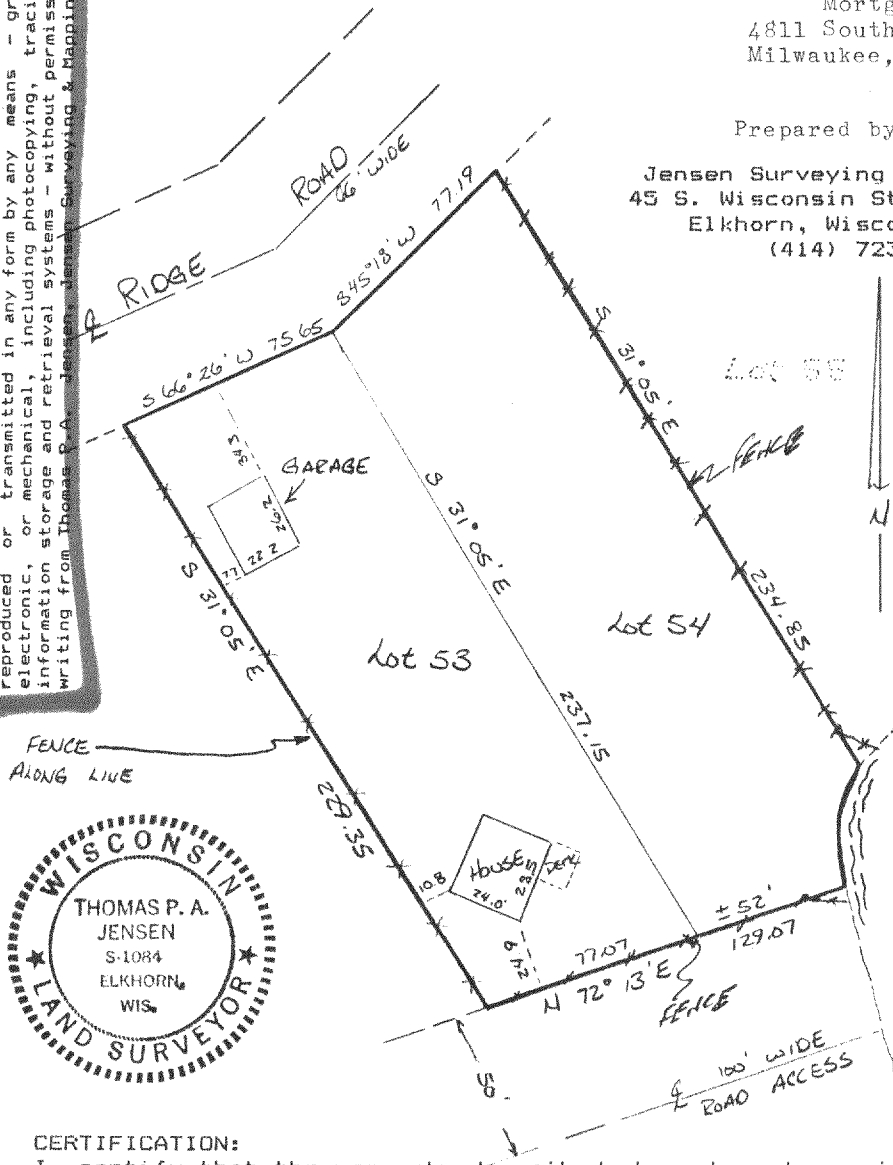

SCALE:

1" = 50'

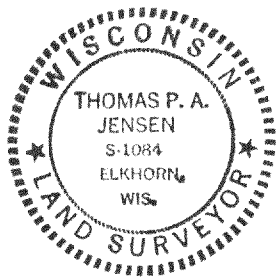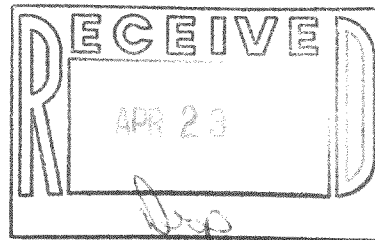

CERTIFICATION:

I certify that the property described above has been inspected
under my responsible direction and supervision and that the above
map is an accurate representation of the property and the
location of all visible structural improvements, if any.

This inspection is made for the exclusive use of the present
owners of the property and also those who purchase, mortgage, or
quarantee the title thereto, and is certified for one year from
the date shown hereon.

Date: APR 2, 87

Thomas P. A. Jensen
Thomas P. A. Jensen R.L.S. 1084 1987 015

DO NOT Photocopy

4851-22.23

416-432