

Found
Iron
Pipe

FOREST ROAD


50.24'

Found
Iron
Pipe

D D Cooper & CO., INC

Rt 4 Box 508B * Elkhorn WI 53121

Survey ordered by Colony Realty

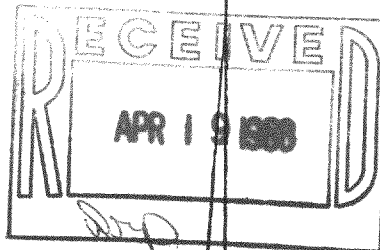

Scale 1"=20'

EXISTING
RESIDENCE

LOT 3

BLOCK 2

Plat of Survey of Lot 3 of Block 2
of Cooper's Mid-Lakes Subdivision
being located in the Town of
LaGrange, Walworth County, Wisconsin

OTHER STEPS
ON PROPERTY WITHIN
LINES NOT LOCATED

I hereby certify that I have surveyed the
property described hereon and that the
map shown hereon is a true and accurate
representation thereof to the best of my
professional knowledge and belief.

Dated this 6 day of April, 1988

Daniel D. Cooper
Daniel D. Cooper, RLS No. S-1464



Found
Iron
Pipe

2.9'

SET 1"X24"
IRON PIPE

STORAGE
SHED

DECK

PIER

56.62'

118°

15'

416-484

DRAWING NO 3209-11-38