


FOREST ROAD

D. D. COOPER & CO., INC.  
Daniel D. Cooper  
Rt. 4 Box 508B  
Elkhorn, WI 53121

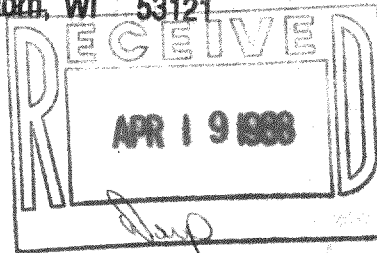

Survey ordered by Modern Realty

FOUND IRON PIPE

FOUND IRON PIPE

FOUND IRON PIPE

CONCRETE PAD

2.0' OVERLINE

FOUND IRON PIPE


SCALE 1"=20'

Plat of Survey of Lot 2 of Block 2  
of Cooper's Mid-Lakes Subdivision  
being located in the Town of  
Lagrange, Walworth County,  
Wisconsin

I hereby certify that I have surveyed  
property described hereon and that the  
map shown hereon is a true and accurate  
representation thereof to the best of  
my professional knowledge and belief.

Dated this                      day of                      , 1987

  
Daniel D. Cooper, RLS No. S-1464

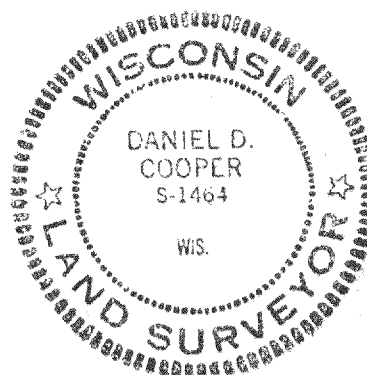

446-485

DRAWING NO. 3092

MIDDLE LAKE

243.38'

139.20'

15'

LOT 2

EXISTING  
RESIDENCE

DECK

50.25'

84°33'

59.18'

242.63'

167.45'

50.15'

10'

FOUND IRON PIPE

UTILITY SHED

FOUND IRON PIPE