


D. Cooper & CO., INC
Rt 4 Box 508B * Elkhorn WI 53121

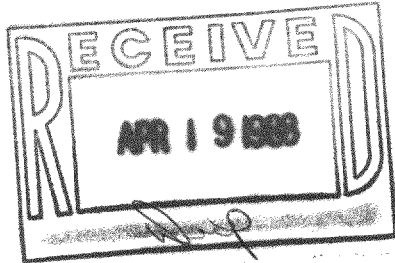


Survey ordered by TLC Realty, Elkhorn, WI

Plat of Survey of Lot 1, Block 14,
Cool Hill Park Addition No. 2, being
located in Town of LaGrange, Walworth
County, Wisconsin.

Bearing referenced to original plat.

Scale 1"=50'

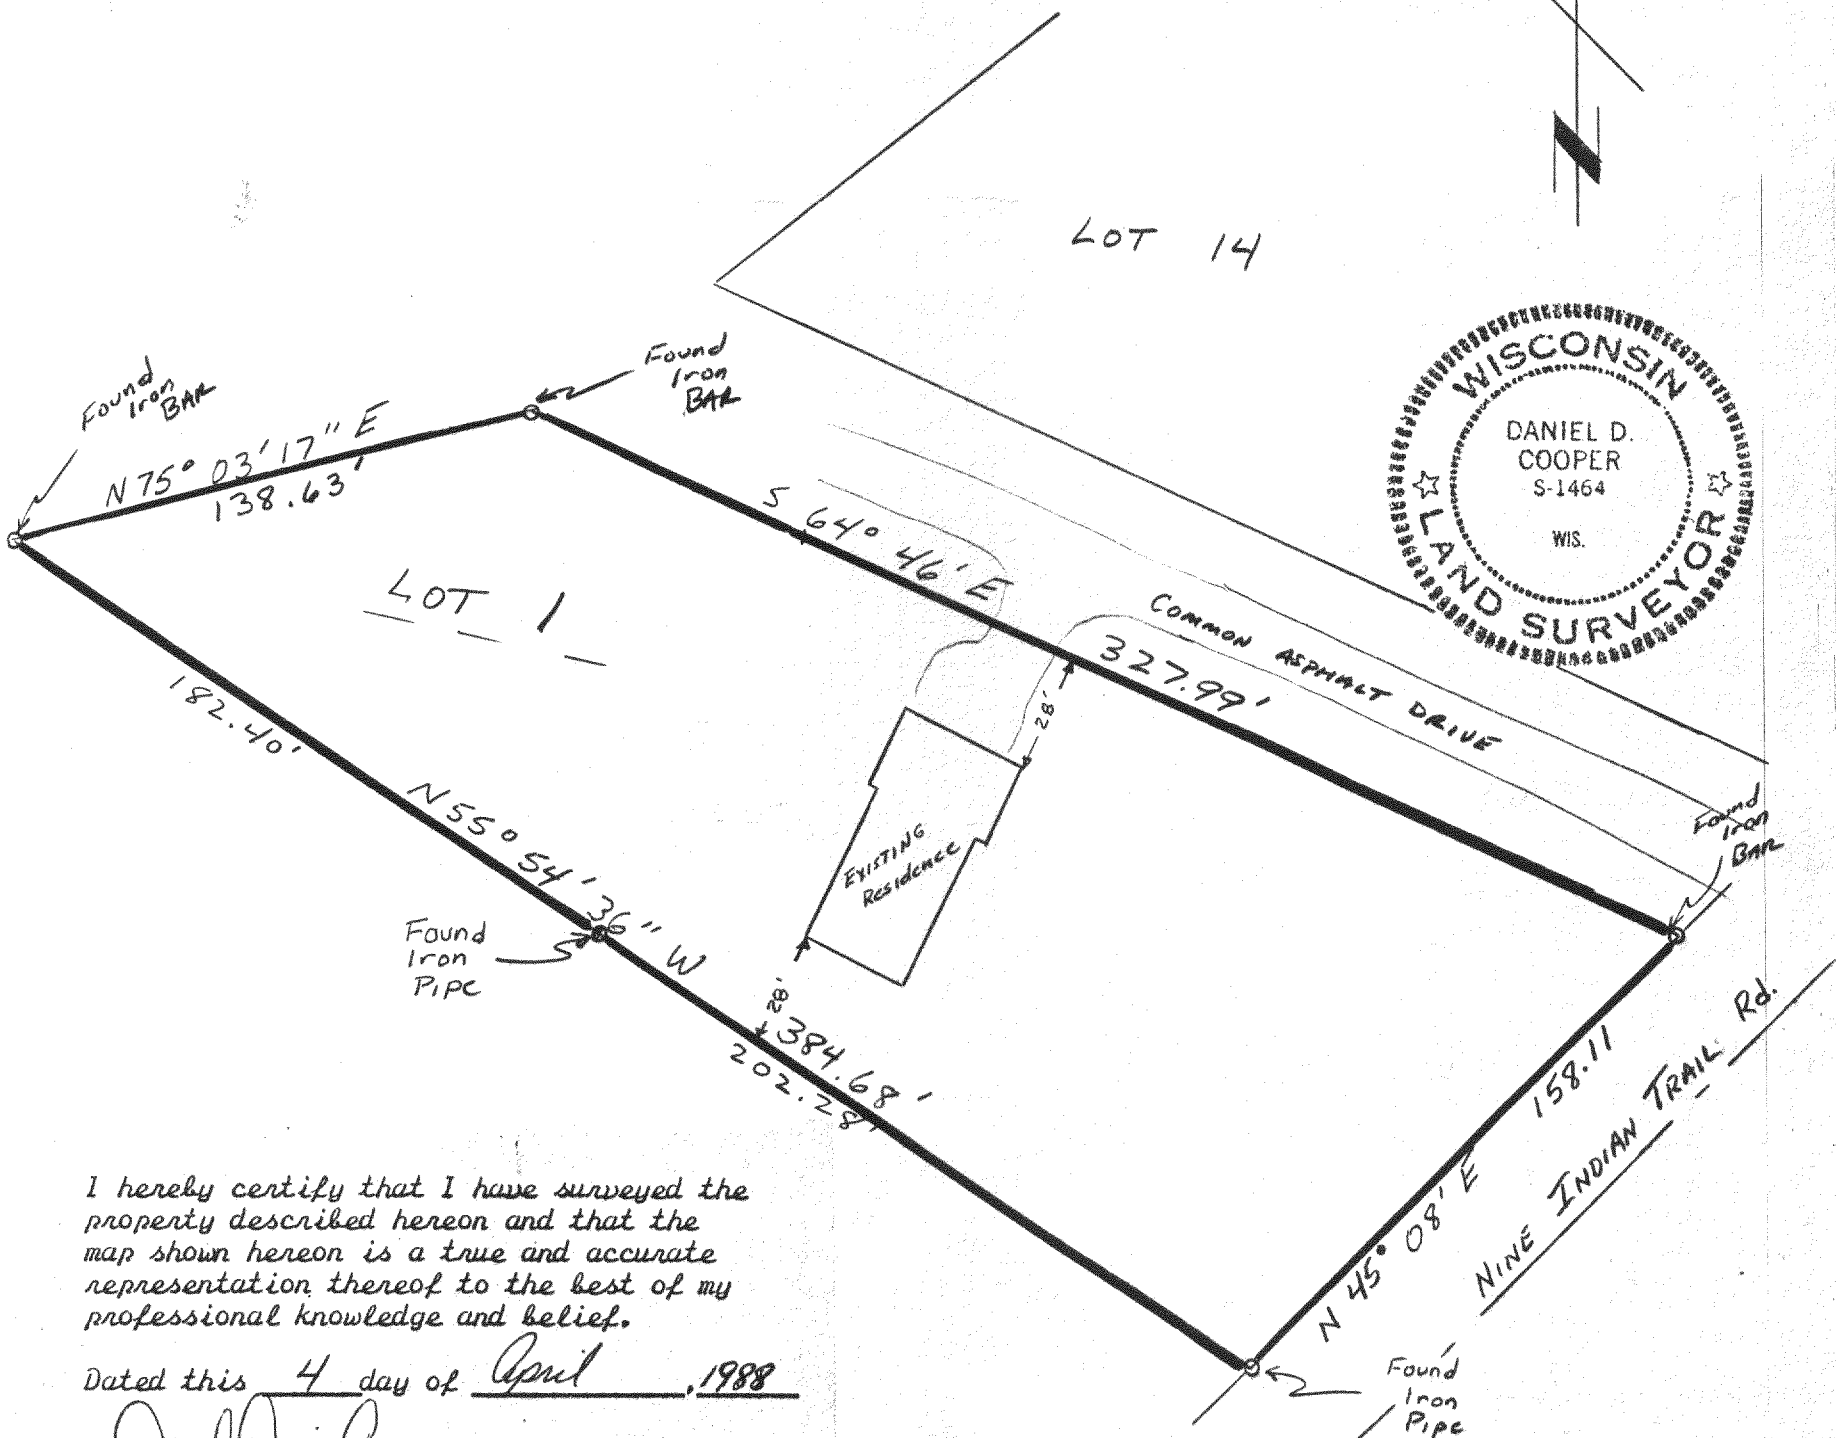

I hereby certify that I have surveyed the
property described hereon and that the
map shown hereon is a true and accurate
representation thereof to the best of my
professional knowledge and belief.

Dated this 4 day of April, 1988

Daniel D. Cooper

Daniel D. Cooper, RLS No. S-1464

DRAWING No. 3201-S

416-491