




Survey ordered by TLC Realty, Elkhorn, WI

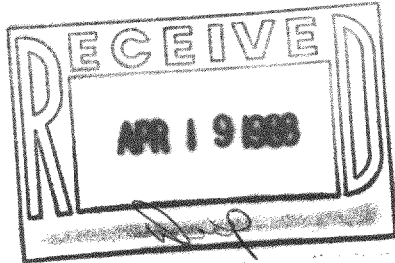

Plat of Survey of Lot 1, Block 14,
 Cool Hill Park Addition No. 2, being
 located in Town of LaGrange, Walworth
 County, Wisconsin.

Bearing referenced to original plat.

Scale 1"=50'

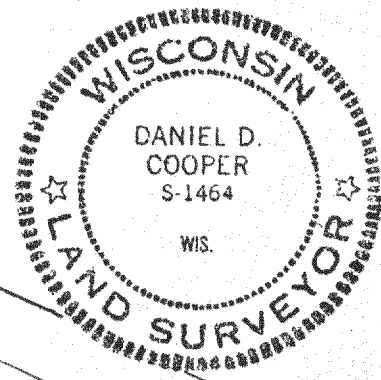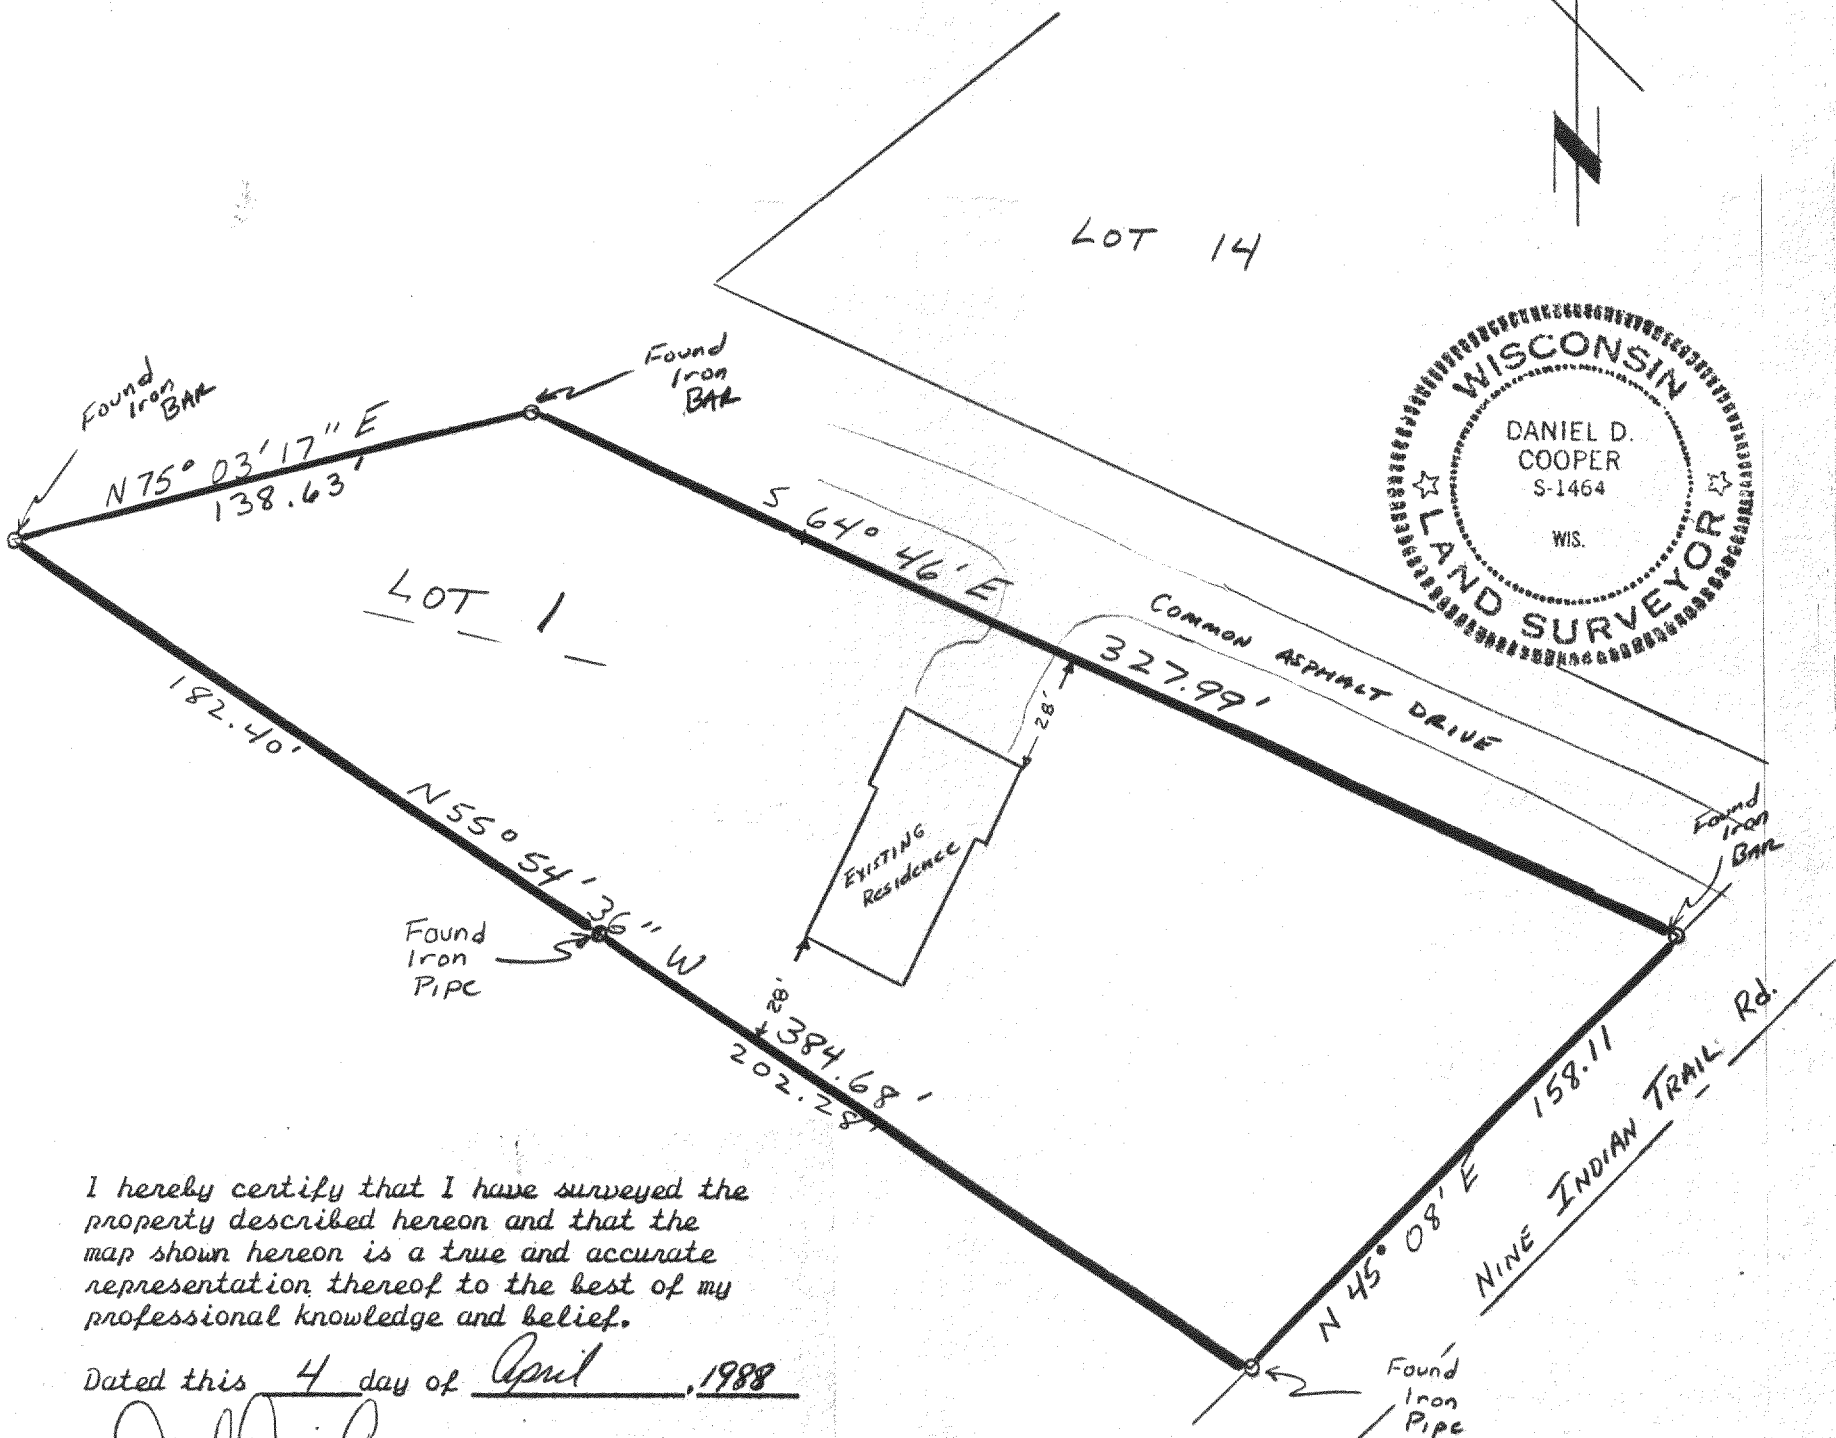

I hereby certify that I have surveyed the
 property described hereon and that the
 map shown hereon is a true and accurate
 representation thereof to the best of my
 professional knowledge and belief.

Dated this 4 day of April, 1988

Daniel D. Cooper

Daniel D. Cooper, RLS No. S-1464

DRAWING No. 3201-S

416-491