
WALWORTH COUNTY SURVEYING & MAPPING LAKE GENEVA, WISCONSIN



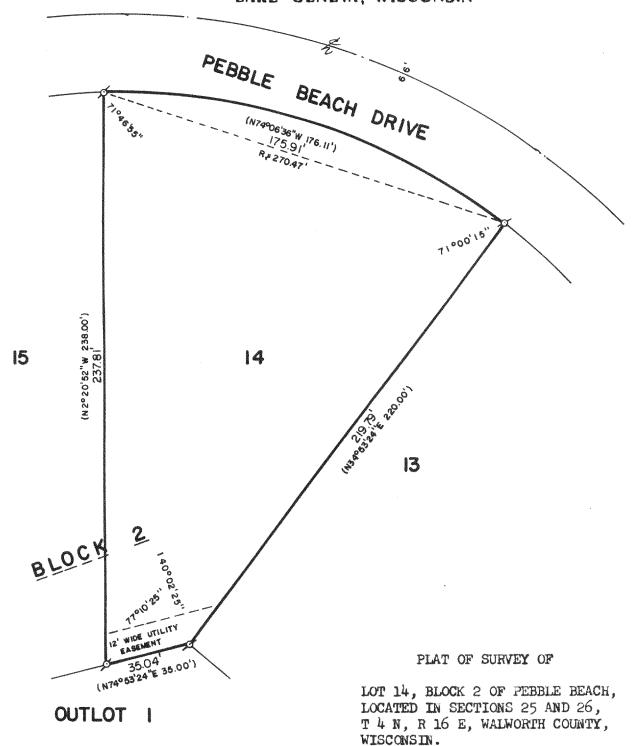

SCAIE: 1"=40'

ø-IRON PIPE FOUND ()-RECORDED AS

NOTE: REFER TO DEED OR GUARANTEE POLICY FOR EASEMENTS NOT SHOWN HEREON.

ORDERED BY: CENTURY 21 GENEVA LAKE 503 CENTER STREET

LAKE GENEVA, WISCONSIN 53147

I HEREBY CERTIFY THAT I HAVE SURVEYED THE ABOVE DESCRIBED PROPERTY AND THAT THE ABOVE MAP IS A TRUE REPRESENTATION THEREOF AND SHOWS THE SIZE AND LOCATION OF THE PROPERTY, ITS EXTERIOR BOUNDARIES, THE LOCATION OF ALL VISIBLE STRUCTURES AND DIMENSIONS OF ALL PRINCIPAL BUILDINGS THEREON, BOUNDARY FENCES, APPARENT EASEMENTS AND ROADWAYS AND VISIBLE ENCROACHMENTS, IF ANY.

THIS SURVEY IS MADE FOR THE EXCLUSIVE USE OF THE PRESENT OWNERS OF THE PROPERTY, AND ALSO THOSE WHO PURCHASE, MORTGAGE, OR GUARANTEE THE TITLE THERETO WITHIN ONE (1) YEAR FROM DATE HEREOF.

ROBERT M. BAERENWALD

WISCONSIN REGISTERED LAND SURVEYOR, S-1508

JOB NO. 1483 DATE

NOTE: THIS IS NOT A CERTIFIED COPY UNLESS SEALED.