Lot 5 of Strawberry Banke Plantation, a Subdivision located in Section 36, TAN, R16E, Town of Lagrange, Walworth County, Wisconsin.

CHRVEYED FOR: Joseph Mracek PFD 5 Boy 165 Elkhorn, WI 69101

SURVEYED BY: Jensen Surveying & Mapping S.C. 45 S. Wisconsin St. P.O. Box 322 Elkhorn, Wisconsin. 53121 (414) 723-3434

Copyright © 1988 by Jensen Surveying & Mapping S.C.


LAUDERDALE LAKE

All rights reserved. No part of this survey plat may be reproduced or transmitted in any form by any means - graphic. electronic, or mechanical. including photocopying, tracing, or information storage and retrieval systems - without permission in writing from Thomas P.A. Jensen, Jensen Surveying & Mapping S.C.

Pearings

referenced to the meander line recorded as 5 %40]] t W on the Subdivision Plat




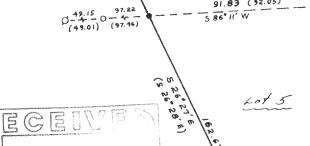



91.83 (92.05)



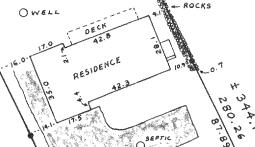


OSEPTIC

O DRY WELL

108.36

(108.30)


--- O -

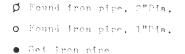

LEGEND

OCT 2 0 1988

Mapping Date: April 25, 1982

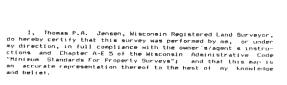

Thomas P.A. Jensen R.L.S-1084 Jensen Surveying & Mapping S.C.

78° 33' 8 (N 78" 28"E) 87.48 N 84° 33'E (N 84° 28'E) 95.54 ω œ &- PLANTATION ROAD

SCALE: 1" = 301