ABERNATHY and ASSOCIATES


Kenneth B. Abernathy Jr.

Wisconsin Registered Land Surveyor

Rt. 3, Box 273

Elkhorn, Wisconsin 53121 Phone: (414) 723-4260 (office)

(414) 723-4813 (residence)

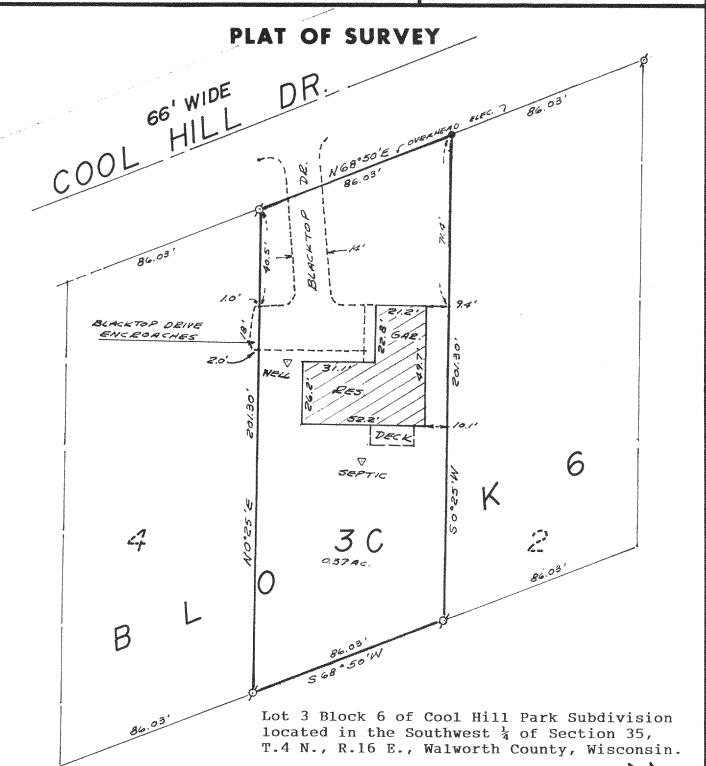

Legend

ordered by: ERA Lanham Realty 20 S. Washington

Elkhorn, WI. 53121

SCALE: 1"=40 FEET

FOUND IRON PIPE

FOUND IRON ROD

FOUND BRASS CAPPED MONUMENT

FOUND CONCRETE MONUMENT

CHISEL CUT IN CONCRETE

SET IRON ROD, 24" LONG, WEIGHING 1.5 LBS./LINEAL FT., 3/4" DIA.

SET IRON ROD, 30" LONG, WEIGHING 4.5 LBS./LINEAL FT., 1-11/16" DIA.

(xx)RECORDED AS DIMENSION

EXISTING FENCE

Karaneth 9. abstriatiny, in. 5-1594 RECHORNA No arms

"I hereby certify that I have surveyed the above described property and that the above map is a true representation thereof and shows the size and location of the property, its exterior boundaries, the location of all visible structures and dimensions of all principal buildings thereon, boundary fences, apparent easements, roadways and visible encroachments, if any."

"This survey is made for the use of the present owners owners

the property, and also those who purchase, mortgage, or guarantee the title thereto within one year from date hereof."

KENNETH B. ABERNATHY, JR. WISCONSIN REGISTERED LAND SURVEYOR, S-1594

6-27-88 Job No. 88.606

416-536

BCEIVE 2 1988