
HAROLD H. KOLB

REGISTERED PROFESSIONAL LAND SURVEYOR LAKE GENEVA, WISCONSIN

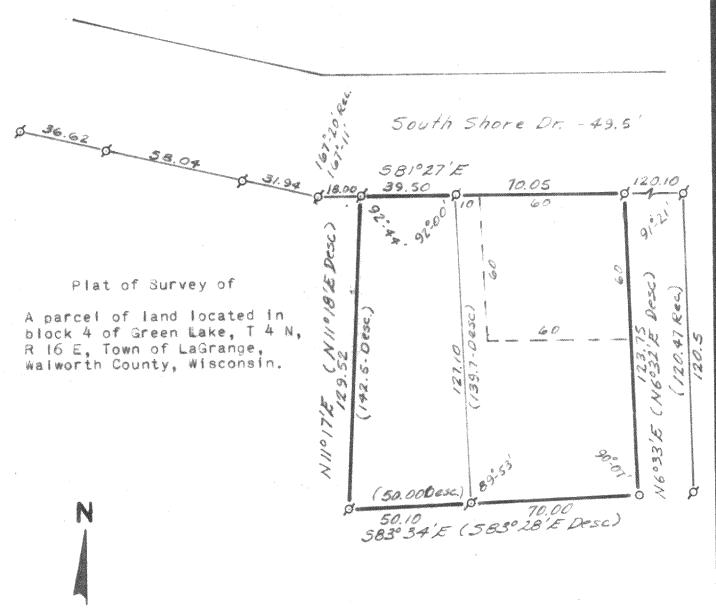

LEGEND

O - IRON PIPE PLACED

• - CONCRETE MONUMENT

X - SPIKE

Scale - 1'= 40'

I, HAROLD H. KOLB, DO HEREBY CERTIFY THAT I HAVE SURVEYED THE PROPERTY HEREON DESCRIBED ACCORDING TO THE OFFICIAL RECORDS, AND THAT THE PLAT HEREON IS A CORRECT REPRESENTATION OF THE LOT LINES.

Harold N. Kolk

HAROLD H. KOLB

WISCONSIN REGISTERED LAND SURVEYOR, S-187

DATE July 7, 1967

Revised: July 25, 1967

416-54

GP - 26

HAROLD H. KOLB

REGISTERED PROFESSIONAL LAND SURVEYOR LAKE GENEVA, WISCONSIN

Description

A parcel of land located in Block 4, Green Lake Park, T 4 N, R 16 E, Walworth County, Wisconsin and described as follows; towit: commencing at the intersection of the South line of South Shore Drive and the East line of said Block 4; thence N 81° 27° N 120.10 feet along the South line of South Shore Drive, to the place of beginning; thence continue N 81° 27° W 109.55 feet; thence S 11° 17° W 129.52 feet; thence S 83° 34° E 120.10 feet; thence N 6° 33° E 123.75 feet to the place of beginning.

LEGEND

Ø - IRON PIPE FOUND

O - IRON PIPE PLACED

• - CONCRETE MONUMENT

X - SPIKE

I, HAROLD H. KOLB, DO HEREBY CERTIFY THAT I HAVE SURVEYED THE PROPERTY HEREON DESCRIBED ACCORDING TO THE OFFICIAL RECORDS, AND THAT THE PLAT HEREON IS A CORRECT REPRESENTATION OF THE LOT LINES.

HAROLD H. KOLB

WISCONSIN REGISTERED LAND SURVEYOR, S-187

DATE July 25, 1967

414-54