


PLAT OF SURVEY OF LOT 5 WALNUT HILLS SUBDIVISION,  
 BEING LOCATED SECTION 36, T4N, R16E, WALWORTH COUNTY,  
 WISCONSIN.

Survey ordered by TLC Realty-Elkhorn

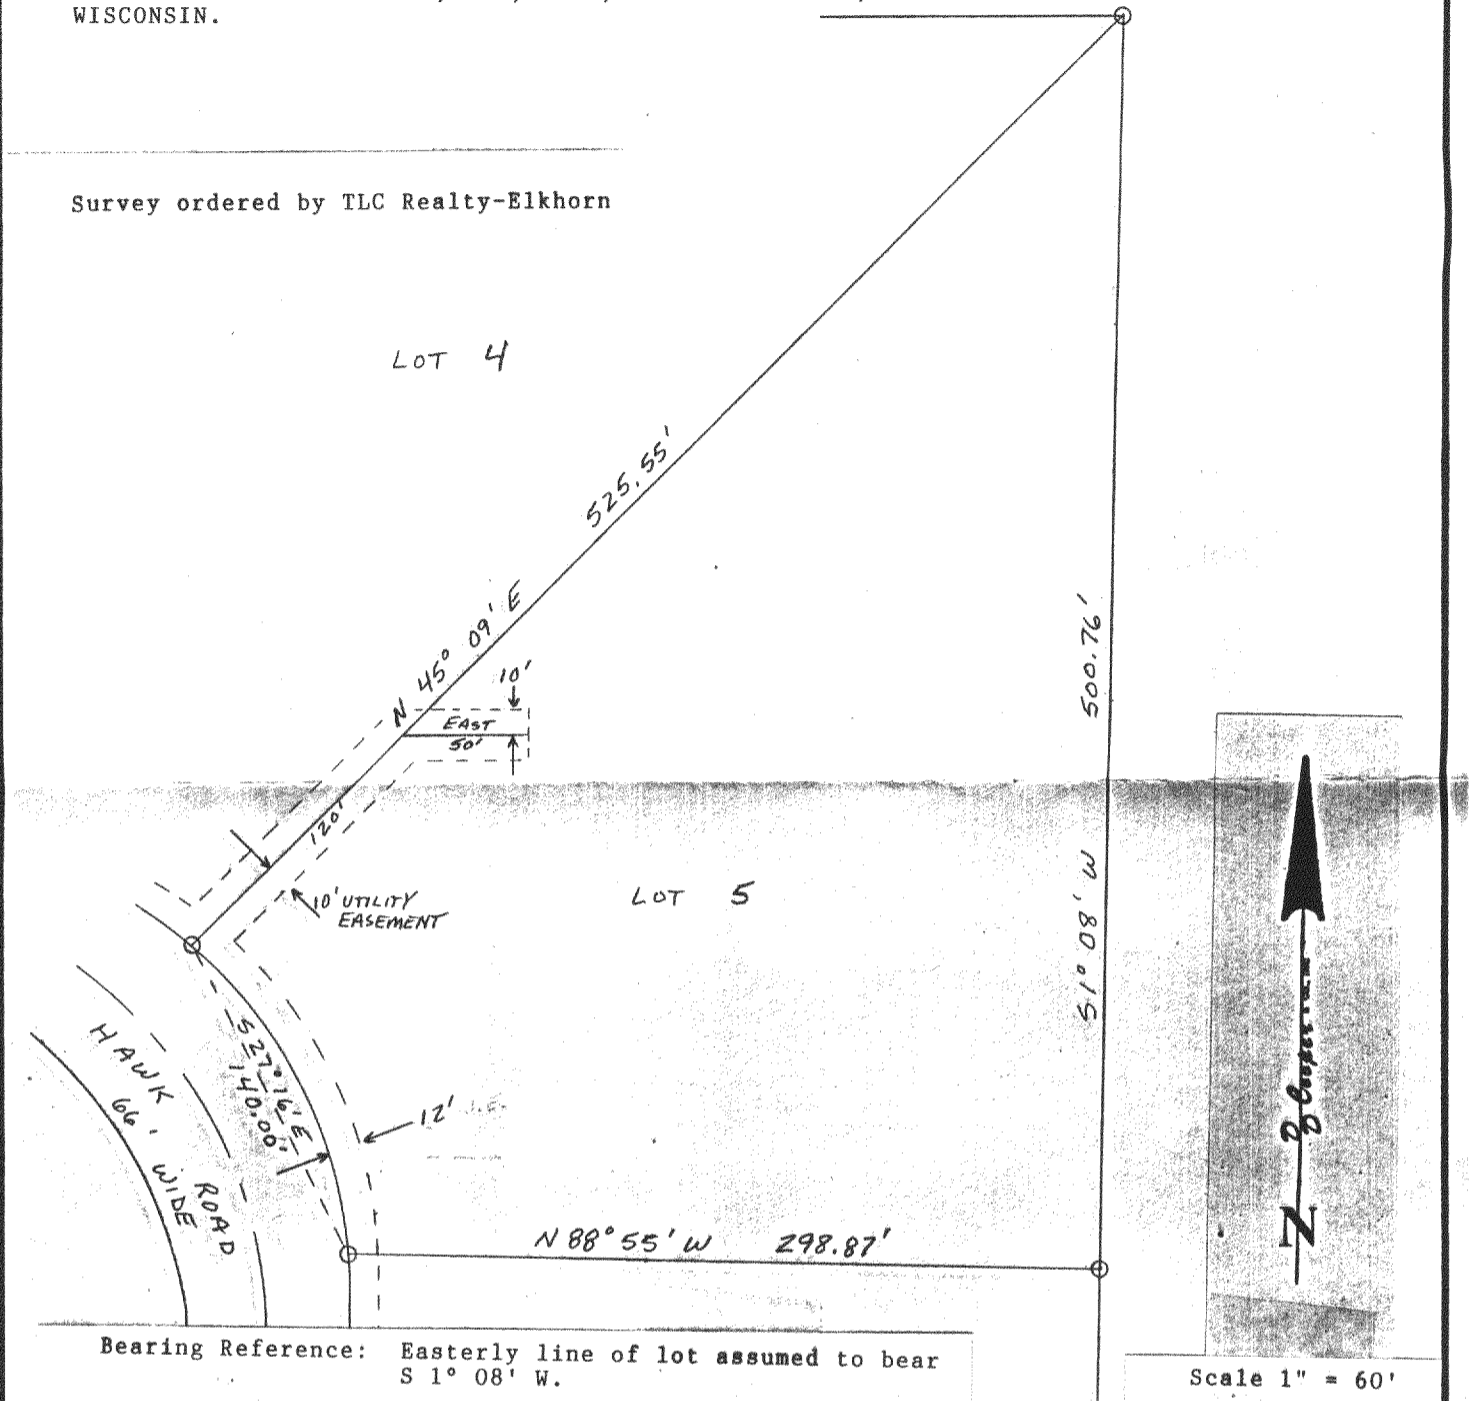

Bearing Reference: Easterly line of lot assumed to bear  
 S 1° 08' W.

Scale 1" = 60'

I hereby certify that I have surveyed the  
 property described hereon and that the  
 map shown hereon is a true and accurate  
 representation thereof to the best of my  
 professional knowledge and belief.

Dated this 4<sup>th</sup> day of JUNE, 1990

*Daniel D Cooper*


Daniel D. Cooper, RLS No. S-1464



Legend:

- - found iron pipe
- ⊙ - set 1" x 24" iron pipe

DRAWING No. 3645

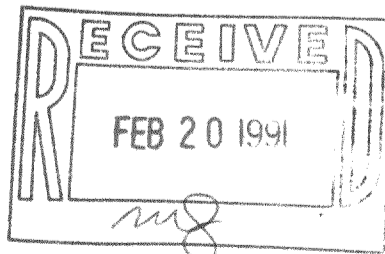

*Reduced*

TAX KEY #

HTLW 00005

416-647