
## **ABERNATHY and ASSOCIATES** Kenneth B. Abernathy Jr.

Wisconsin Registered Land Surveyor

Rt. 3, Box 273 Elkhorn, Wisconsin 53121 Phone: (414) 723-4260 (office) (414) 723-4813 (residence)

## PLAT OF SURVEY

Lot 24 of SOUTHMOOR SUBDIVISION, LOCATED IN THE SOUTHWEST & OF SECTION 25, TOWN 4 NORTH, RANGE 16 EAST, WALWORTH CQUNTY, WISCONSIN.

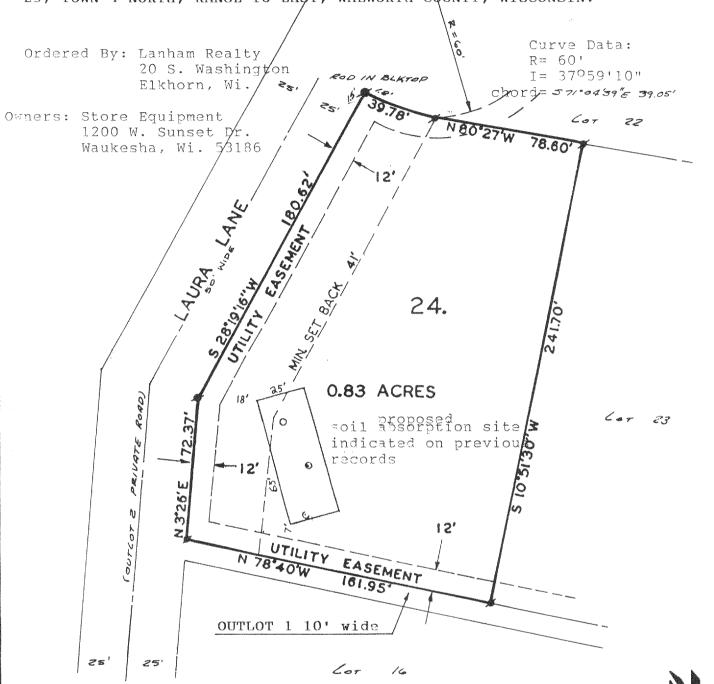

## Legend

FOUND IRON PIPE

FOUND IRON ROD

FOUND BRASS CAPPED MONUMENT

FOUND CONCRETE MONUMENT

CHISEL CUT IN CONCRETE

SET IRON ROD, 24" LONG, WEIGHING 1.5 LBS./LINEAL FT., 3/4" DIA.

SET IRON ROD, 30" LONG, WEIGHING 4.5 LBS./LINEAL FT., 1-11/16" PANISON SCONS KENNETH B. ABERNATHY, JR. S-1594 ELKHORN, WI WIND SURVENIE NOA | 5 1880

SCALE: 1"= 50 FEET

"I hereby certify that I have surveyed the above described property and that the above map is a true representation thereof and shows the size and location of the property, its exterior boundaries, the location of all visible structures and dimensions of all principal buildings thereon, boundary fences, apparent easements, roadways and visible encroachments, if any."

"This survey is made for the use of the present owners of

the property, and also those who purchase, mortgage, or guarantee the title thereto within one year from date hereof."

KENNETH B. ABERNATHY, JR. WISCONSIN REGISTERED LAND SURVEYOR. S-1594

9/26/90 Date:\_\_\_\_ Job No. 90.913