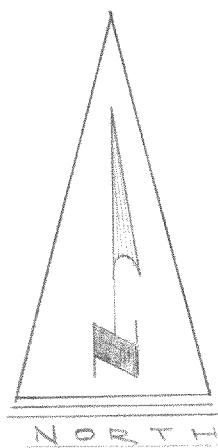
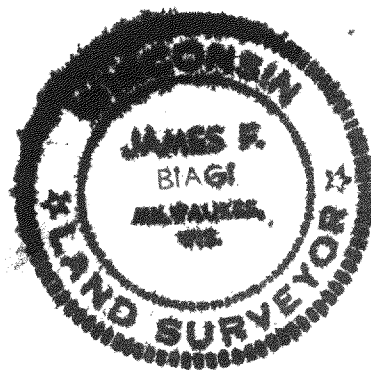


#61-64

PLACE
OF
BEGINNINGS 2° 28' E 294.75'
294.75'58.95'
N 83° 29' E

3.02 ACRES

N 40° 56' E 571.31'
571.31'GREENING ROAD
S 40° 56' W 442.05'246.00' W. 12° 08' 10.3'
10.3'
25'
91'
15.5'

DESCRIPTION: A parcel of land located in the NE $\frac{1}{4}$ of Section 14, T. 4 N., R. 16 E, Walworth County, Wisconsin, described as follows, to wit: Commencing at the SW corner of said NE $\frac{1}{4}$, thence north along the N-S $\frac{1}{4}$ section line 1,333.33 feet to the center line of the Town Road; thence East along the center line of said Town Road 768.35 feet; thence N. 40° 56' E along the center line of said road 659.51 feet to the place of beginning; thence S. 2° 28' E. 294.75 feet; thence N. 83° 29' E along a fence 58.95 feet; thence N. 40° 56' E. 571.31 feet; thence N. 39° 21' W. 246.00 feet to the center line of said road; thence S. 40° 56' W. along the center line of said road 442.05 feet to the place of beginning.

CERTIFICATE: I, James F. Biagi, surveyor, do hereby certify that I have surveyed the property hereon described and that the location of the improvements are as shown.

July 24, 1964.

James F. Biagi RLS 272

LG-14-1A3

416-6B