


PLAT OF SURVEY

LOT  
103 OF MARINER HILLS SUBD.  
LOCATED IN SECTION 34, T.4 N., R.16 E.,  
WALNORTH COUNTY, WISCONSIN.

OWNER: MIKE OLSON  
103 MARINER HILLS  
ELKHORN, WI. 53121

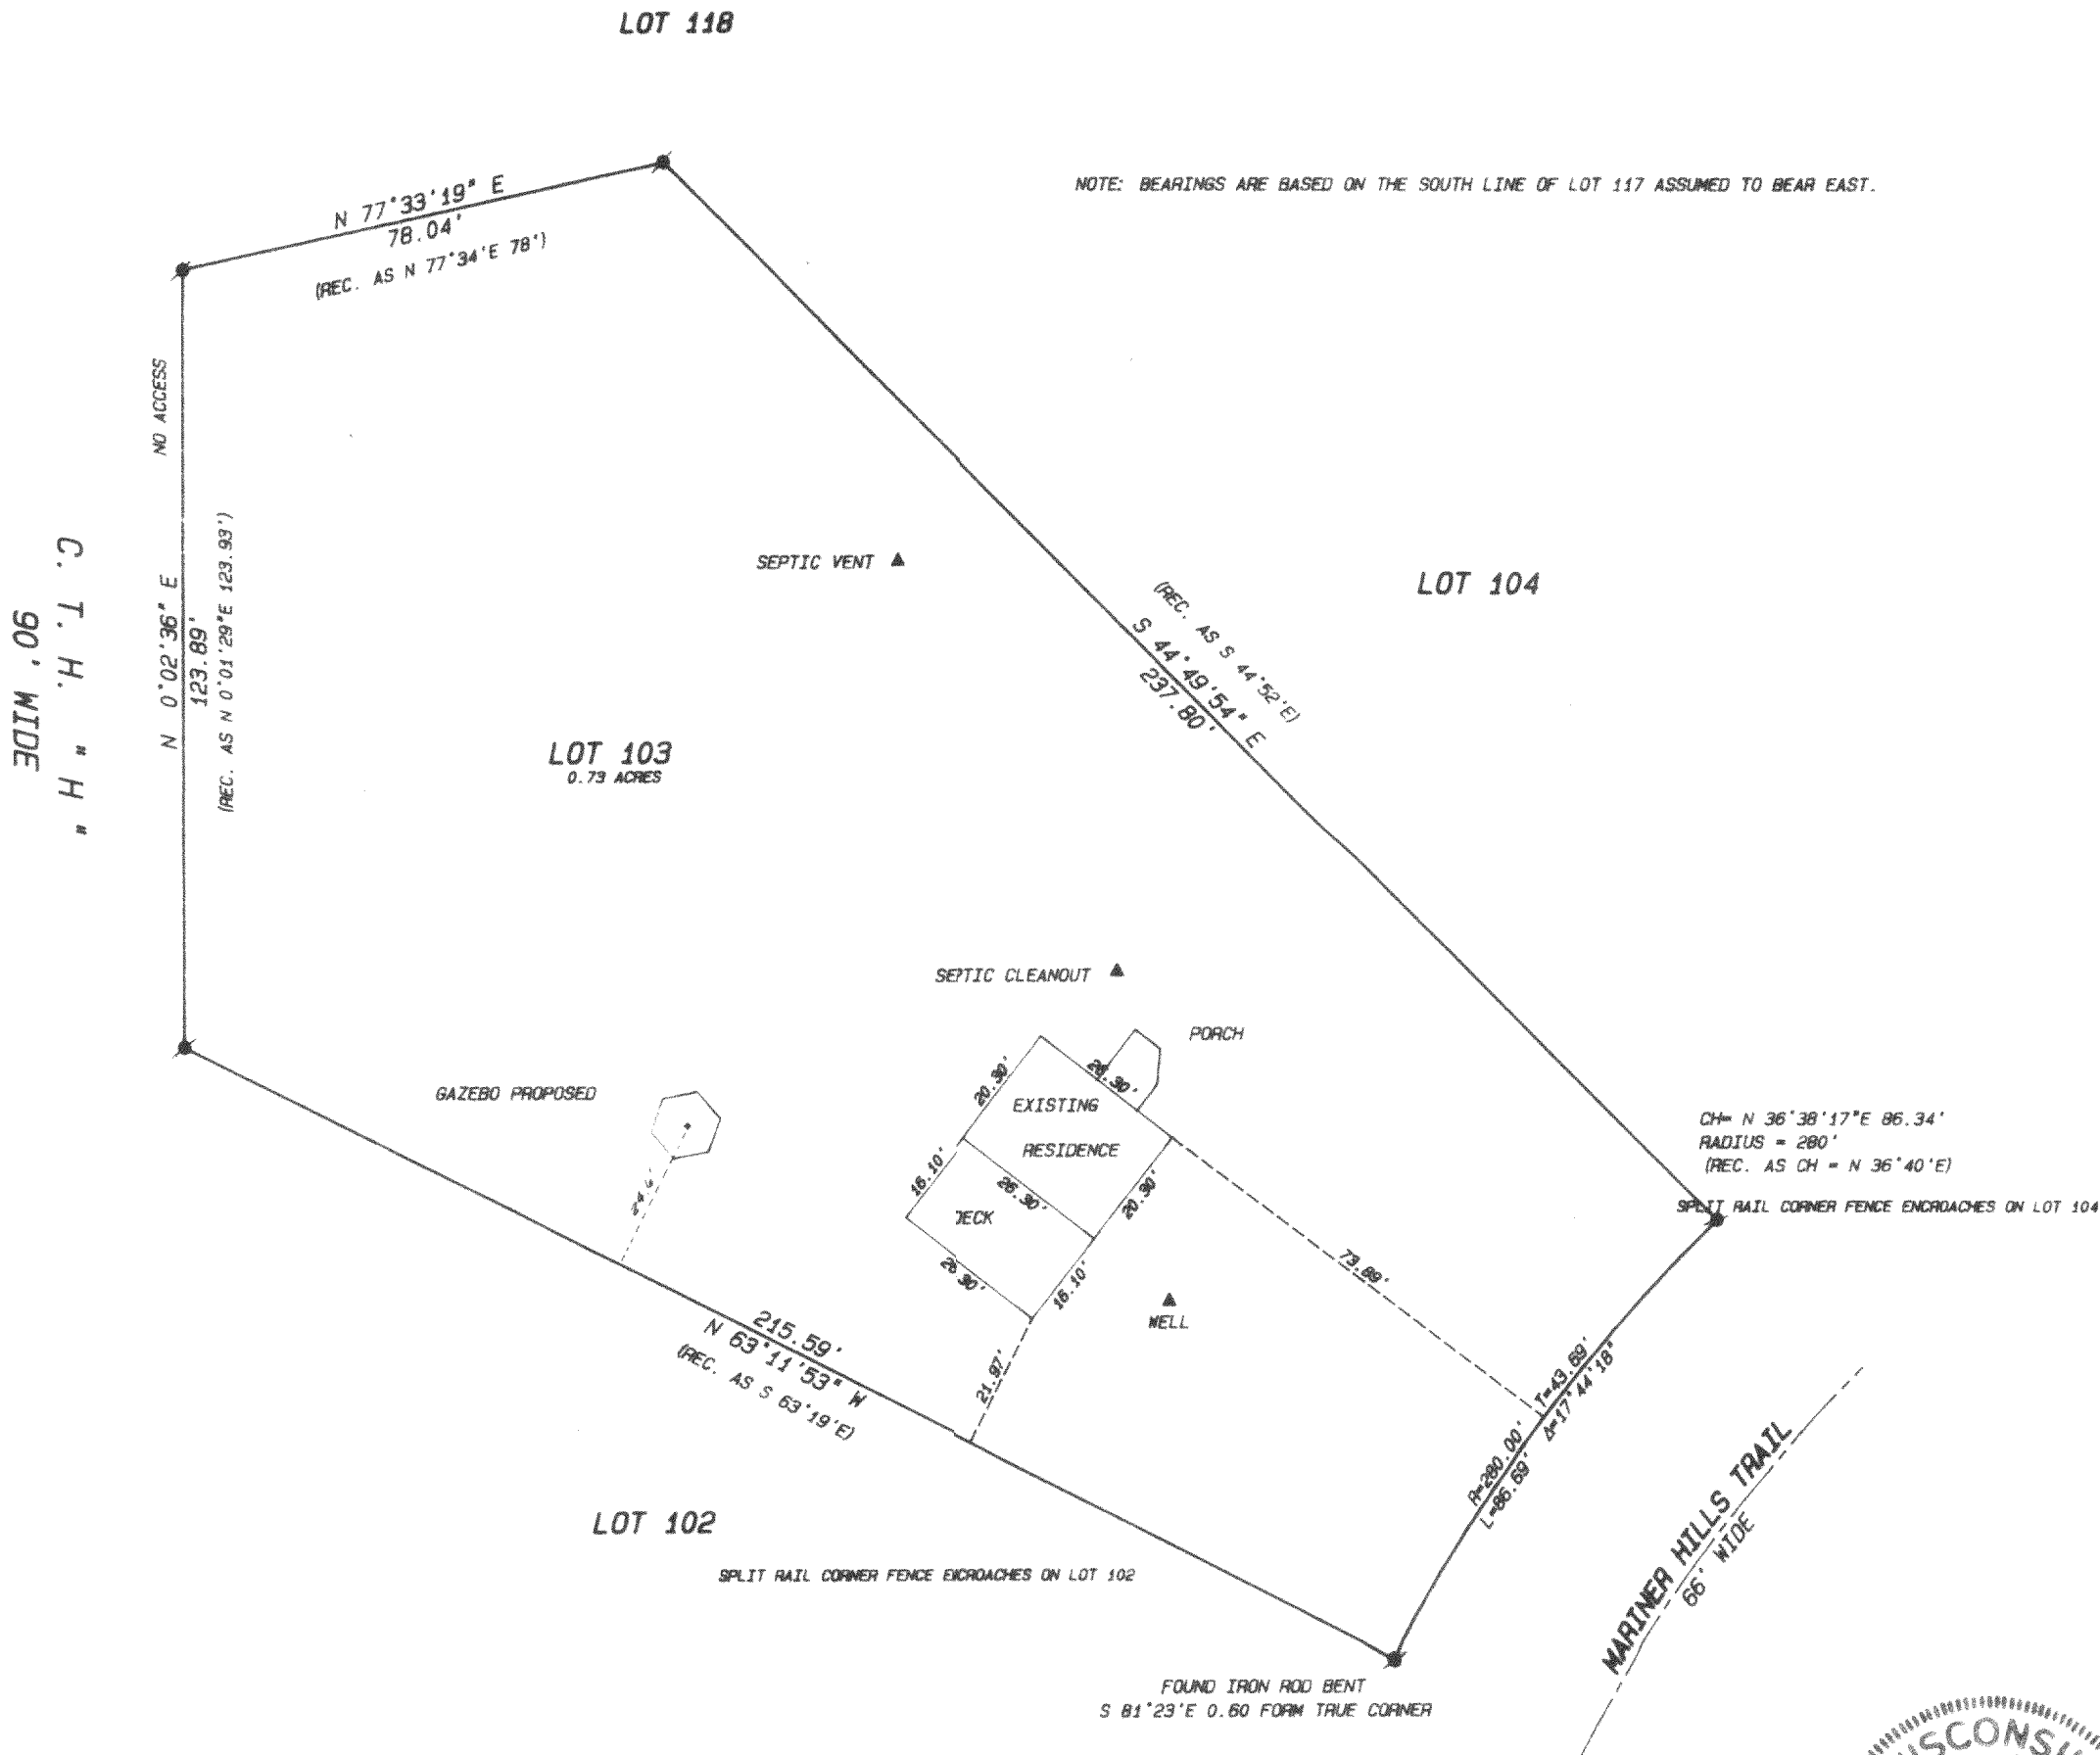

- Legend
- FOUND IRON PIPE
  - FOUND IRON ROD
  - FOUND BRASS CAPPED MONUMENT
  - FOUND CONCRETE MONUMENT
  - CHISEL CUT IN CONCRETE
  - SET IRON ROD, 24\"/>

RECEIVED  
APR 9 1991

SCALE: 1\"/>



"I hereby certify that I have surveyed the above described property and that the above map is a true representation thereof and shows the size and location of the property, its exterior boundaries, the location of all visible structures and dimensions of all principal buildings thereon, boundary fences, apparent easements, roadways and visible encroachments, if any."

"This survey is made for the use of the present owners of the property, and also those who purchase, mortgage, or guarantee the title thereto within one year from date hereof."

*Kenneth B. Abernathy Jr.*  
KENNETH B. ABERNATHY, JR.  
WISCONSIN REGISTERED LAND SURVEYOR,  
S-1594

Date: 7/4/90 Job No. 90 612