


LEGAL DESCRIPTION OF LAND
SURVEYED PROVIDED TO SURVEYOR
BY OWNER STONE AS THE BASIS
FOR SURVEY WORK ORDER CONTRACT
FEB 3, 1989

Real estate described as follows:
The North East 10 feet of lot 5 of Green Island Town
of LaGrange and the North East 10 feet of the vacated
piece South East of lot 5 lying between the aforementioned
10 feet of lot 5 and the road as now used; lot 4 of
Green Island, the South and Southwesterly 10 feet of
lot 3 running along the entire North East side of
lot 4 of Green Island, and West 1/2 a parcel of land
consisting of lots 2 and 3 described as follows:
Commencing at the most Southerly corner of Lot One
(1) of said Subdivision, thence Northerly 5.24 feet
along the Westerly line of said Lot One (1); thence
S. 54° 07' W. 13.83 feet to the place of beginning;
thence S. 54° 07' W. 28.03 feet to the Southwesterly
line of Lot Two (2) of said Subdivision; thence S.
38° 17' W. to a point that is located 10 feet Northerly
of (measured at right angles) the Southwesterly line
of said Lot three (3); thence Northwesterly along a
line parallel to and 10 feet from said Southwesterly
line of Lot three (3) to the shore of Green Lake;
thence Northerly along the shore to a point
that is located N. 27° 04' W. 120.28 feet from the
place of beginning; thence S. 27° 04' E. 120.28 feet
to the place of beginning.
It is understood and agreed that the West half
means that portion West of an imaginary line from a
point equal distance from the limits of the above
described shore line and an equal distance from the
limits of the above described rear line.
All being in a subdivision of Section 26,
Township 4 North Range 16 East of the 4th Principal
Meridian in Walworth County Wisconsin.


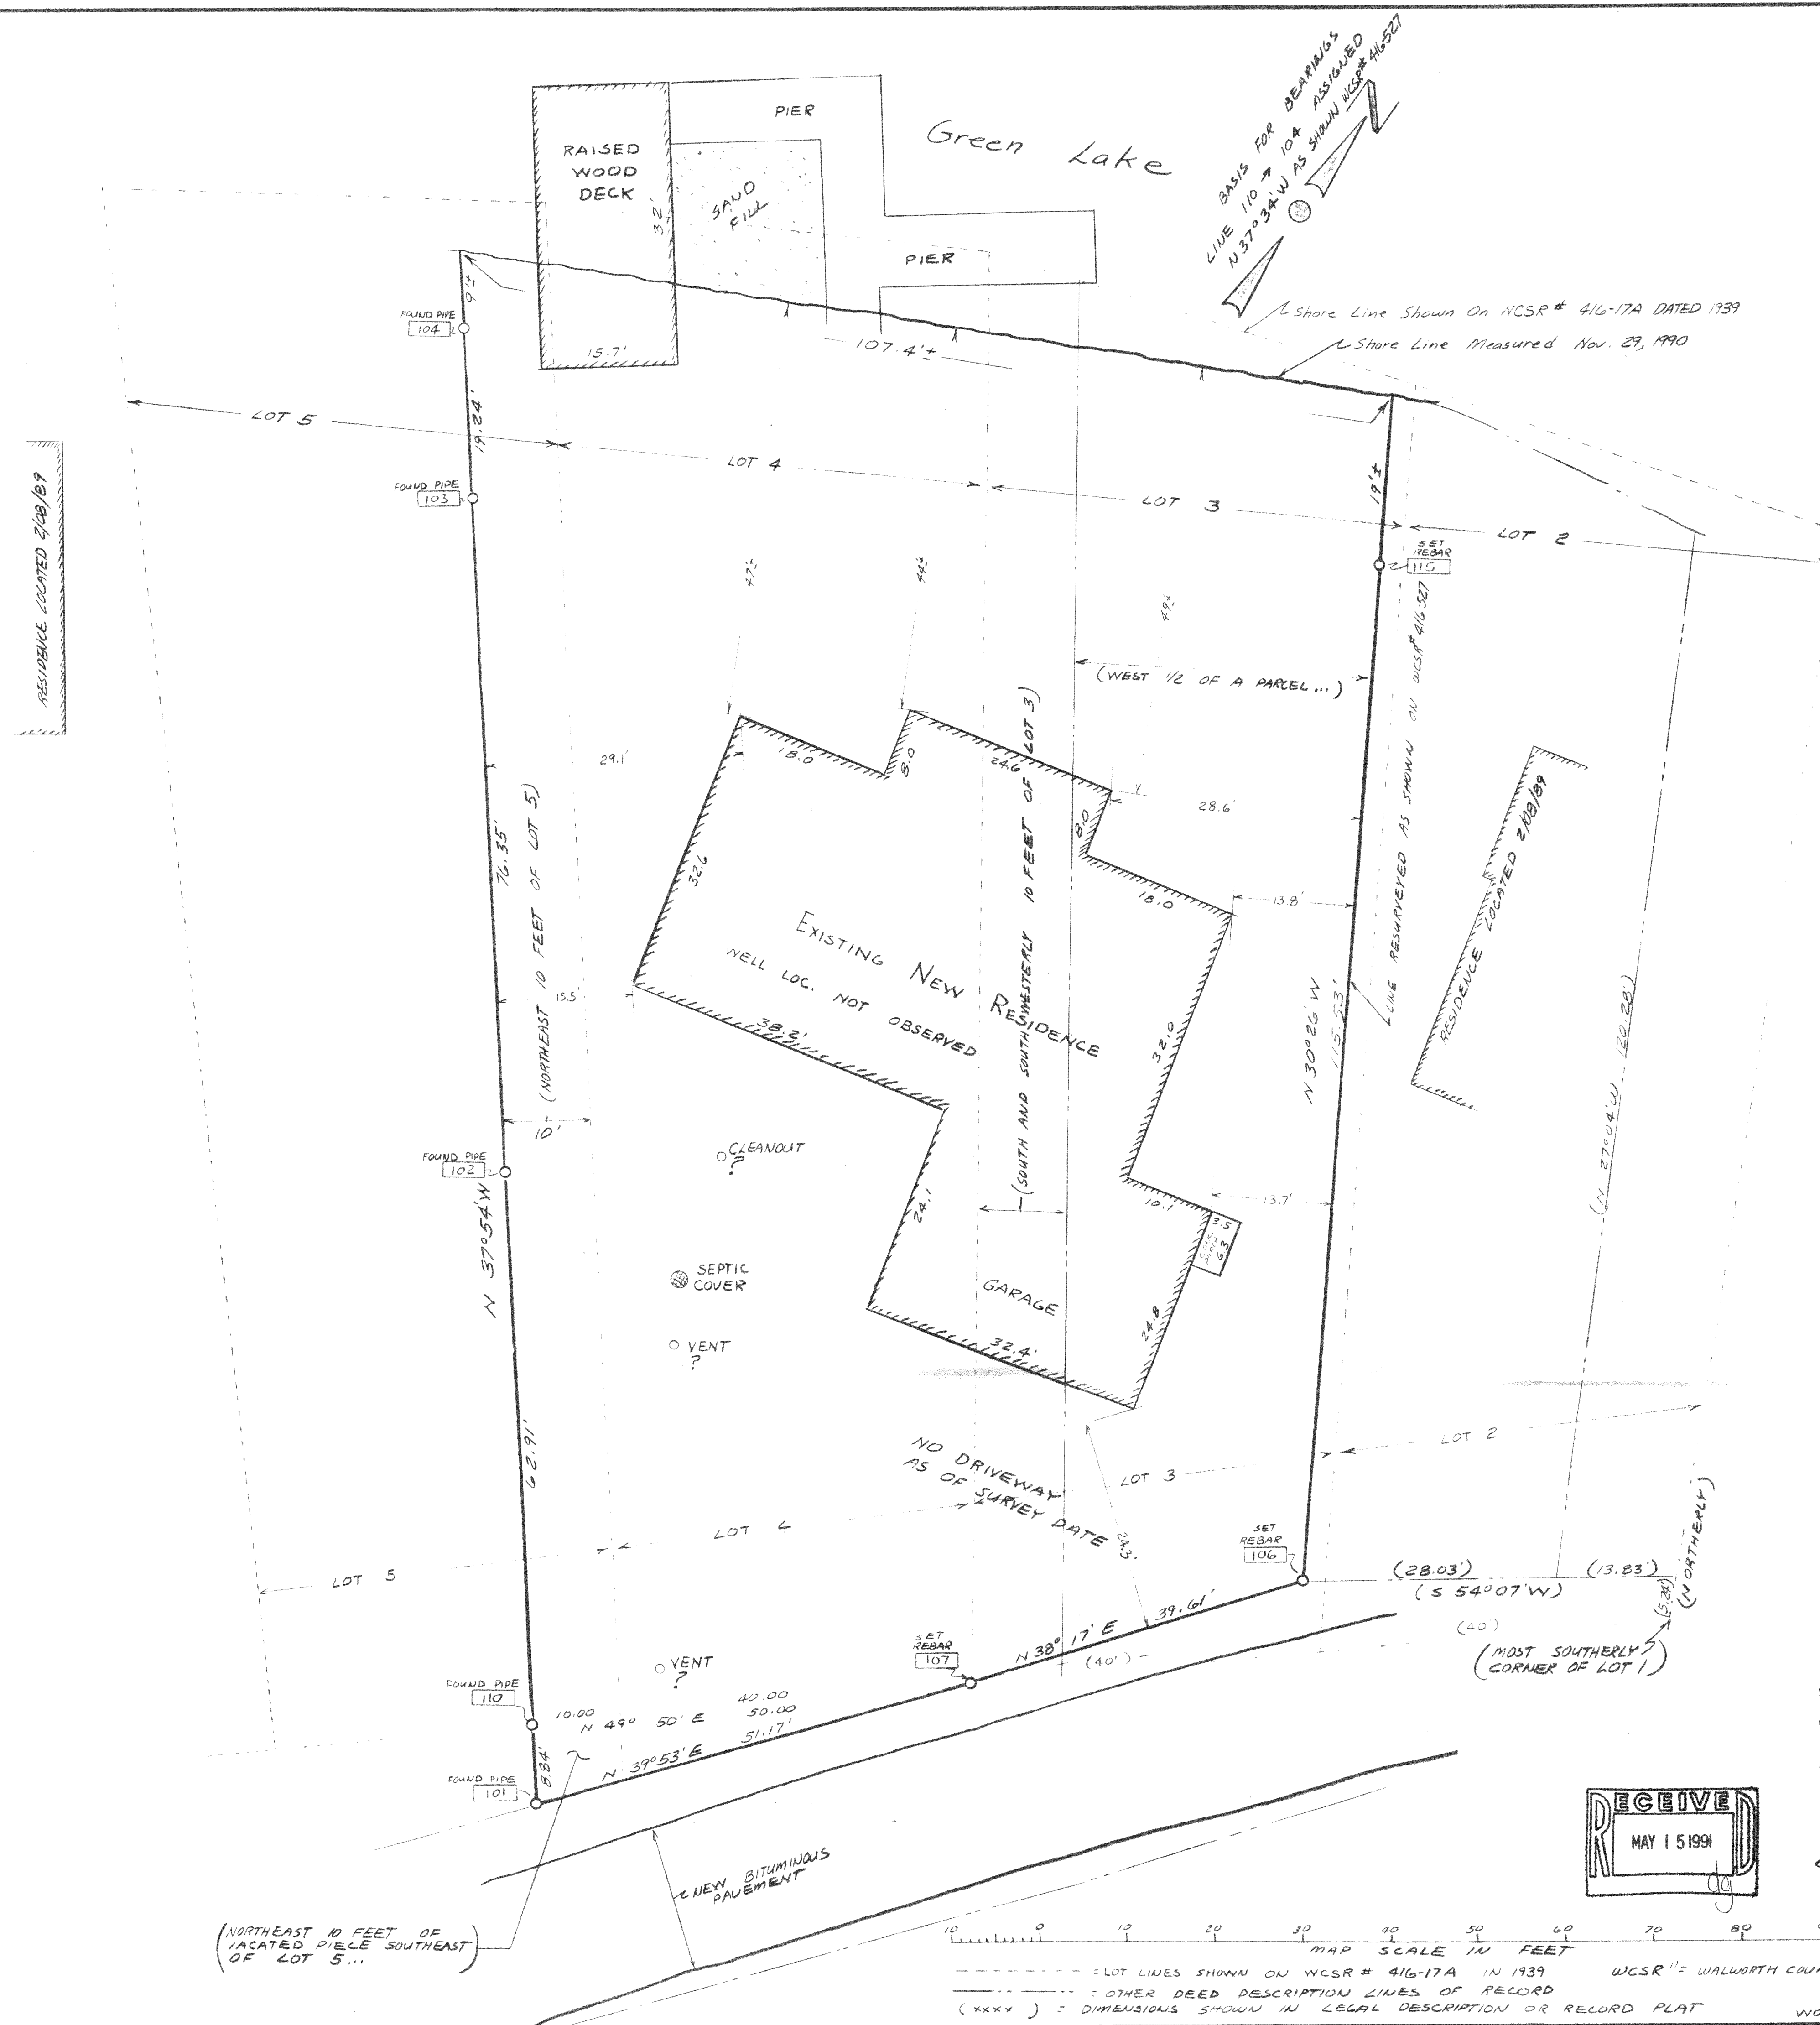


NOTE: COPIES OF THIS MAP TO WHICH THE FOLLOWING CERTIFICATE SHALL APPLY ARE BLUE LINE PRINTS SHOWING
THE SURVEYOR'S ORIGINAL SEAL AND SIGNATURE IN BLACK INK. COPIES BY ANY OTHER MEANS MAY CONTAIN
ALTERATIONS WHICH DO NOT REPRESENT THE SURVEYOR'S WORK PRODUCT.

I HEREBY CERTIFY THAT THE PROPERTY DESCRIBED HEREON HAS BEEN SURVEYED UNDER MY DIRECTION AND THAT THIS
MAP IS A TRUE AND ACCURATE REPRESENTATION OF THE SIZE AND LOCATION OF THE PROPERTY, ITS BOUNDARY
DIMENSIONS AND MONUMENTS AND THE LOCATION OF A NEW RESIDENCE EXISTING AS OF THE DATE HEREOF.

DATED THIS 29TH DAY OF NOVEMBER, 1990

Robert A. Farris
ROBERT A. FARRIS, RLS

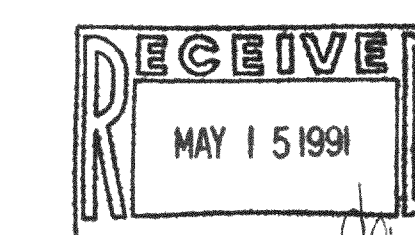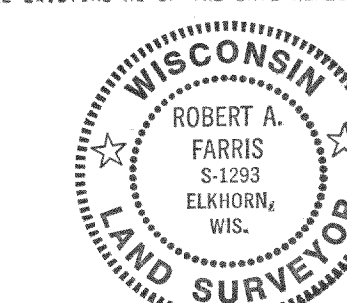

MAP SCALE IN FEET
0 10 20 30 40 50 60 70 80 90 100

LOT LINES SHOWN ON WCSR # 416-17A IN 1939
OTHER DEED DESCRIPTION LINES OF RECORD
(XXXX) = DIMENSIONS SHOWN IN LEGAL DESCRIPTION OR RECORD PLAT
WCSR = WALWORTH COUNTY SURVEYOR'S RECORD #

WORK ORDERED BY THELEN TOTAL CONSTRUCTION

PLAT OF SURVEY
TAX PARCEL # GI-2
WALWORTH CO., WI.

FARRIS, HANSEN & ASSOCIATES, INC.
Engineering, Architecture, Surveying
7 Ridgway Court P.O. Box 437
ELKHORN, WISCONSIN 53121
Office: (414) 723-2098
Fax: (414) 723-5886

REVISIONS

PROJECT NO
3166
DATE
11/29/90
SHEET NO.
1 of 1