
ABERNATHY and ASSOCIATES

Kenneth B. Abernathy Jr.

Rt. 3, Box 273 Elkhorn, Wisconsin 53121 Phone: (414) 723-4260 (office) (414) 723-4813 (residence)

Wisconsin Registered Land Surveyor S-1594

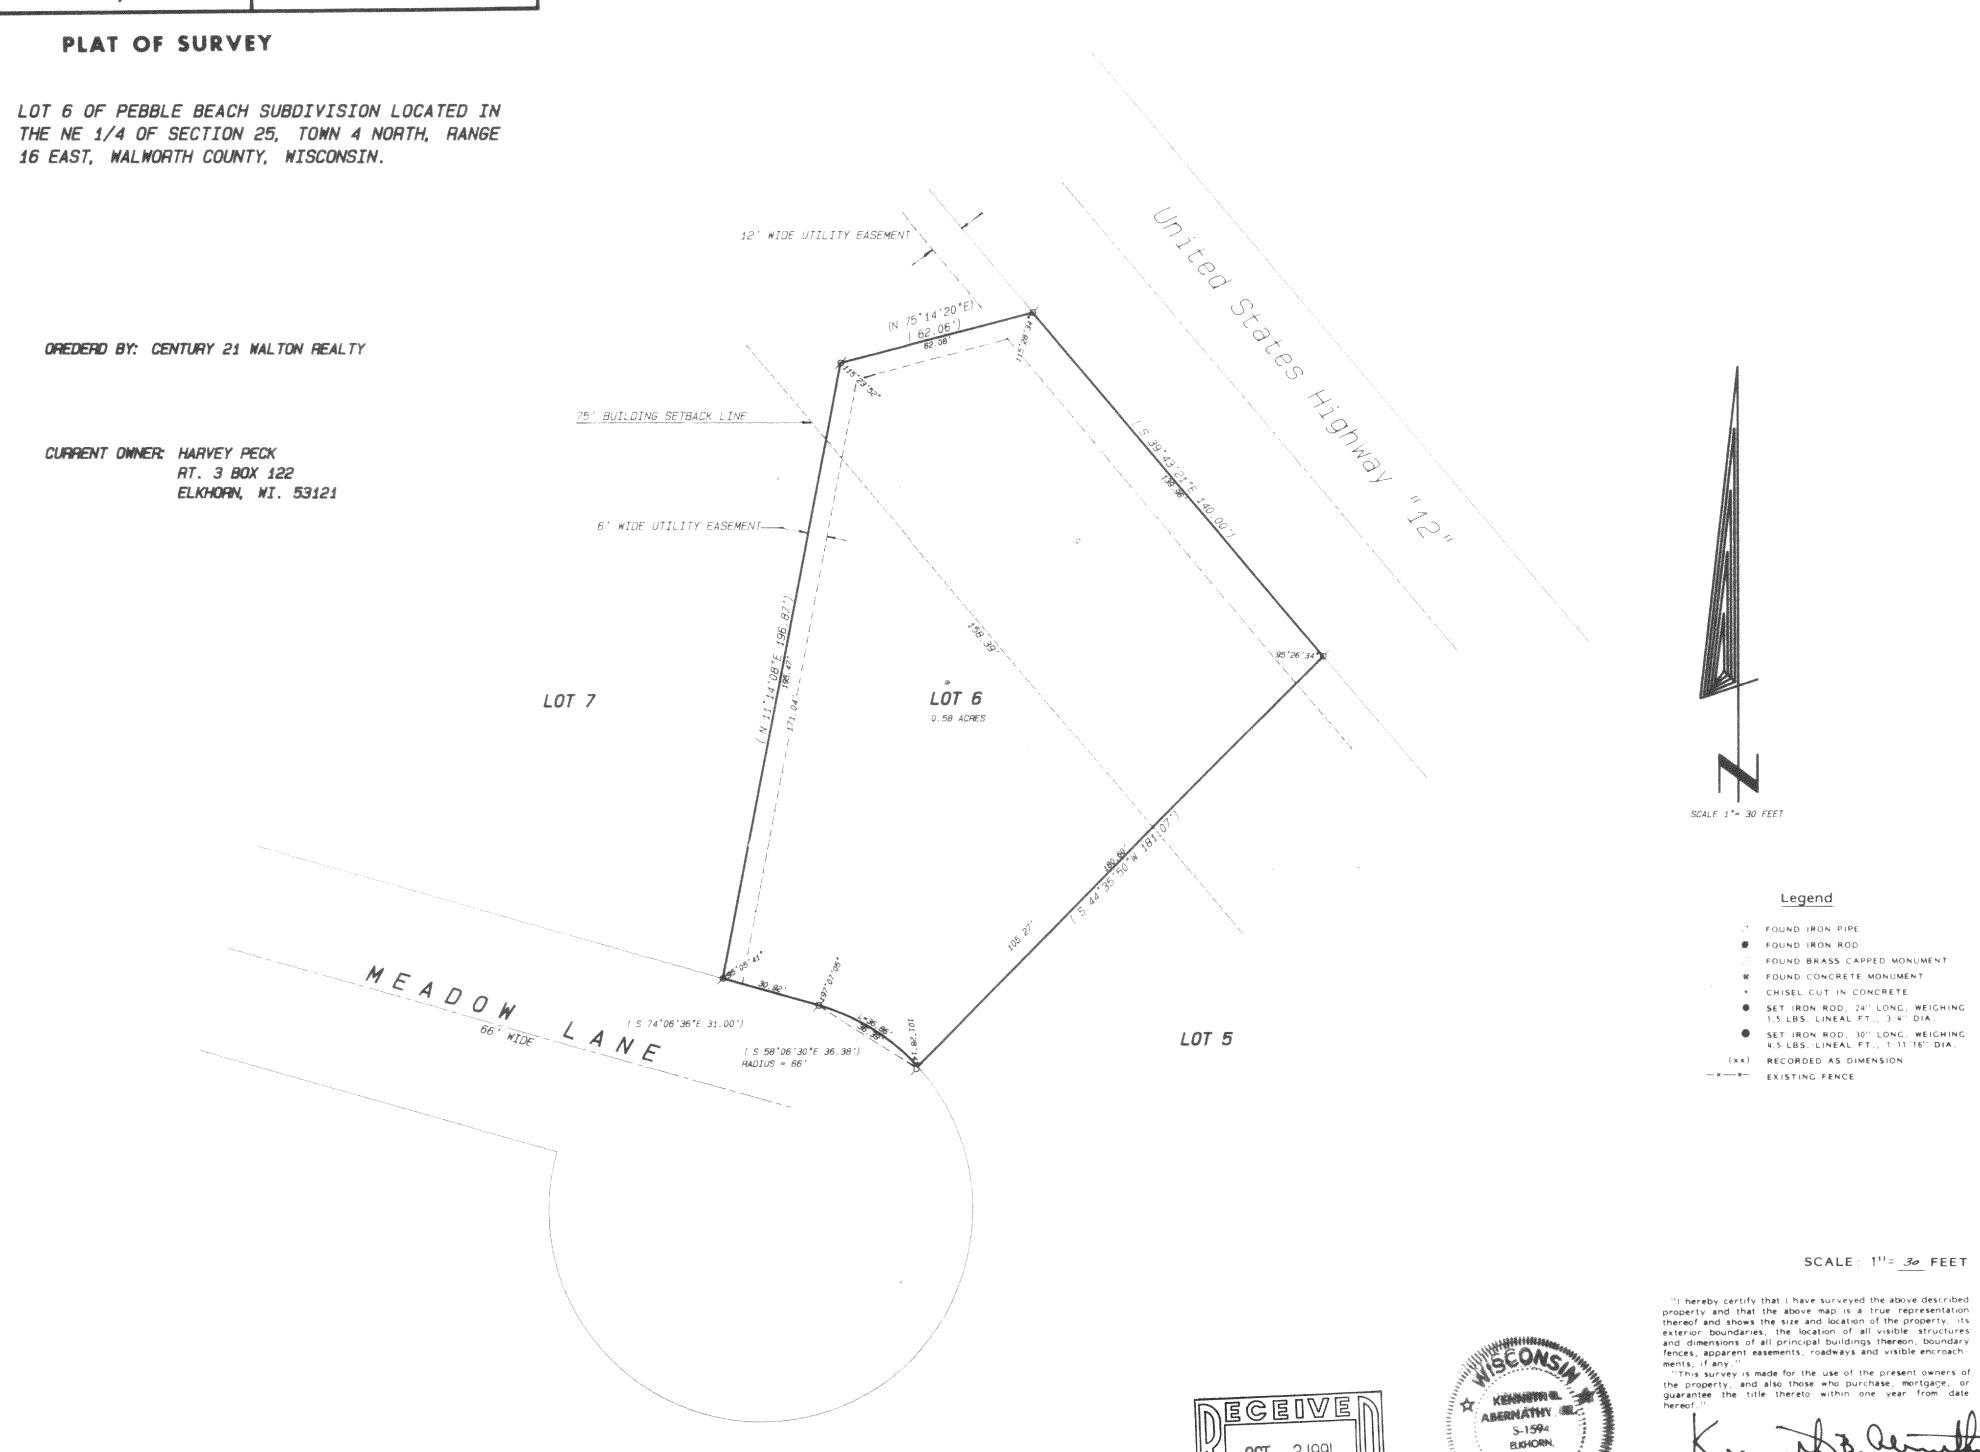

KENNETH B. ABERNATHY, JR.

WISCONSIN REGISTERED LAND SURVEYOR,

Date: 0c100ER 2, 1991 Job No. 91.923