Plat of Survey

of


Copyright (C) 1991 by Jensen Surveying & Mapping S.C.

All rights reserved. No part of this survey plat may be reproduced or transmitted in any form

by any means - graphic, electronic, or mechanical, including photocopying, tracing, or information storage and retrieval systems - without permission in writing from Thomas P.A. Jensen.

LOT 8 OF CLOVERLEAF ACRES, A SUBDIVISION LOCATED IN THE SW 1/4 OF THE NW 1/4 OF SECTION 18, T 4 N, R 16 E, WALWORTH COUNTY, WISCONSIN

Surveyed for: EGNOSKI CONSTRUCTION 377 ANN ST. WHITEWATER, WI 53190

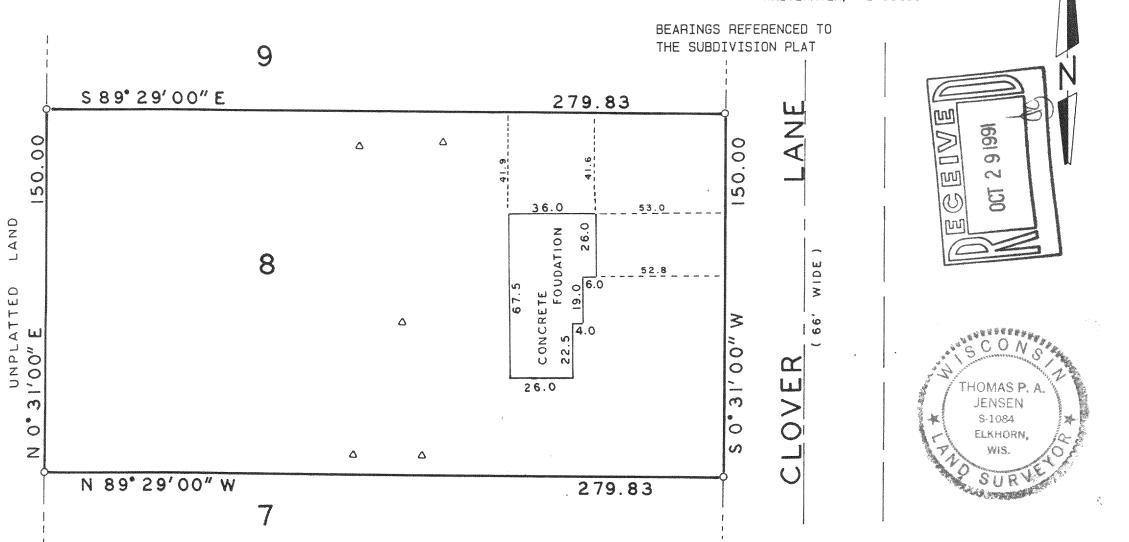

I. Thomas P.A. Jensen, Wisconsin Registered Land Surveyor, do hereby certify that this survey was performed by me, or under my direction, in full compliance with the owner's/agent's instructions and Chapter A-E 7 of the Wisconsin Administrative Code 'Minimum Standards For Property Surveys', and that this map is an accurate representation thereof to the best of my knowledge and belief.

Note: This survey plat is not certified unless signed and sealed in red ink.

Thomas P.A. Jewsen R.L.S. 1084

Hensen Surveying & Mapping S.C. 45 South Wisconsin Street P.O. Box 322 Elkhorn, Wisconsin. 53121.

1991

AUGUST

Mapping date:

45 South Wisconsin Street P.O. Box 322
Elkhorn, Wisconsin. 53121.
(414) 723–3434
Scale: 1 = 40'
0 20 40 80 12

1991

Sheet

Legend Found iron pipe, 1" dia. Wood stake set by builder

0 0

stokes

A Soil boring