Survey Plat

6

Lot 9 of Dunbar Estates Subdivision, located in the Southeast 1/4 of Section 36, Town 4 North, Range 16 East, Town of LaGrange, Walworth County. Wisconsin.

(N 89° 56' 51" W


565.00)

LOT 9

598.01)

EGEIVE

OCT 2 9 1991

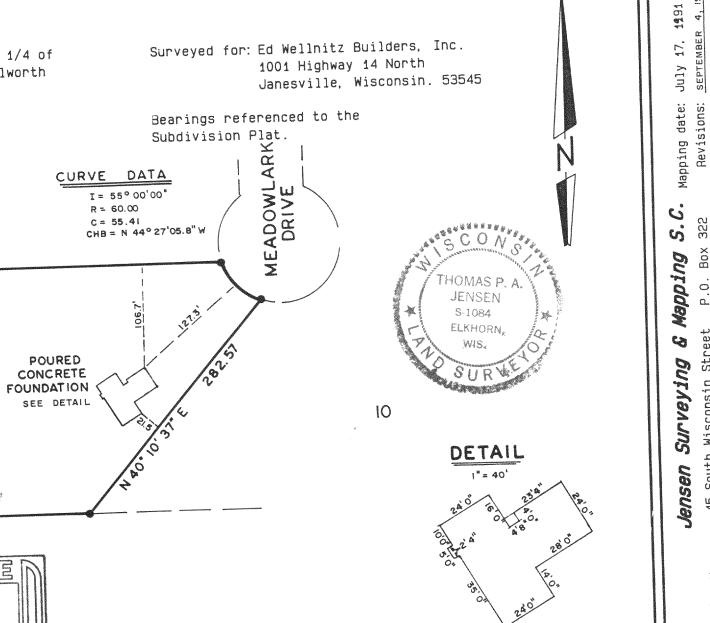

Copyright c 1991 by Jensen Surveying & Mapping S.C.

(N 89°51'41" E

All rights reserved. No part of this survey plat may be reproduced or transmitted in any form by any means - graphic, electronic, or mechanical, including photocopying, tracing, or information storage and retrieval systems - without permission in writing from Thomas P.A. Jensen.

I. Thomas P.A. Jensen. Wisconsin Registered Land Surveyor, do hereby certify that this or under my direction, in full compliance with the owner's/agent's instructions and Chapter A-E 7 of the Wisconsin Administrative Code ' Minimum Standards For Property Surveys ', and that this map is an accurate representation thereof to the best of my knowledge and belief.

Note: This survey plat is not certified unless signed and sealed in red ink.

Willen Thomas P.A. Jensen/ R.L.S. 1084

●~Found iron rod, 3/4° d:)~Recorded as dimension) ~ Wood stake regend

Sheets

P.0. 53121.

South Wisconsin Street Elkhorn, Wisconsin. (414) 723–3434

Jensen

45

J 121.127

Job reference