


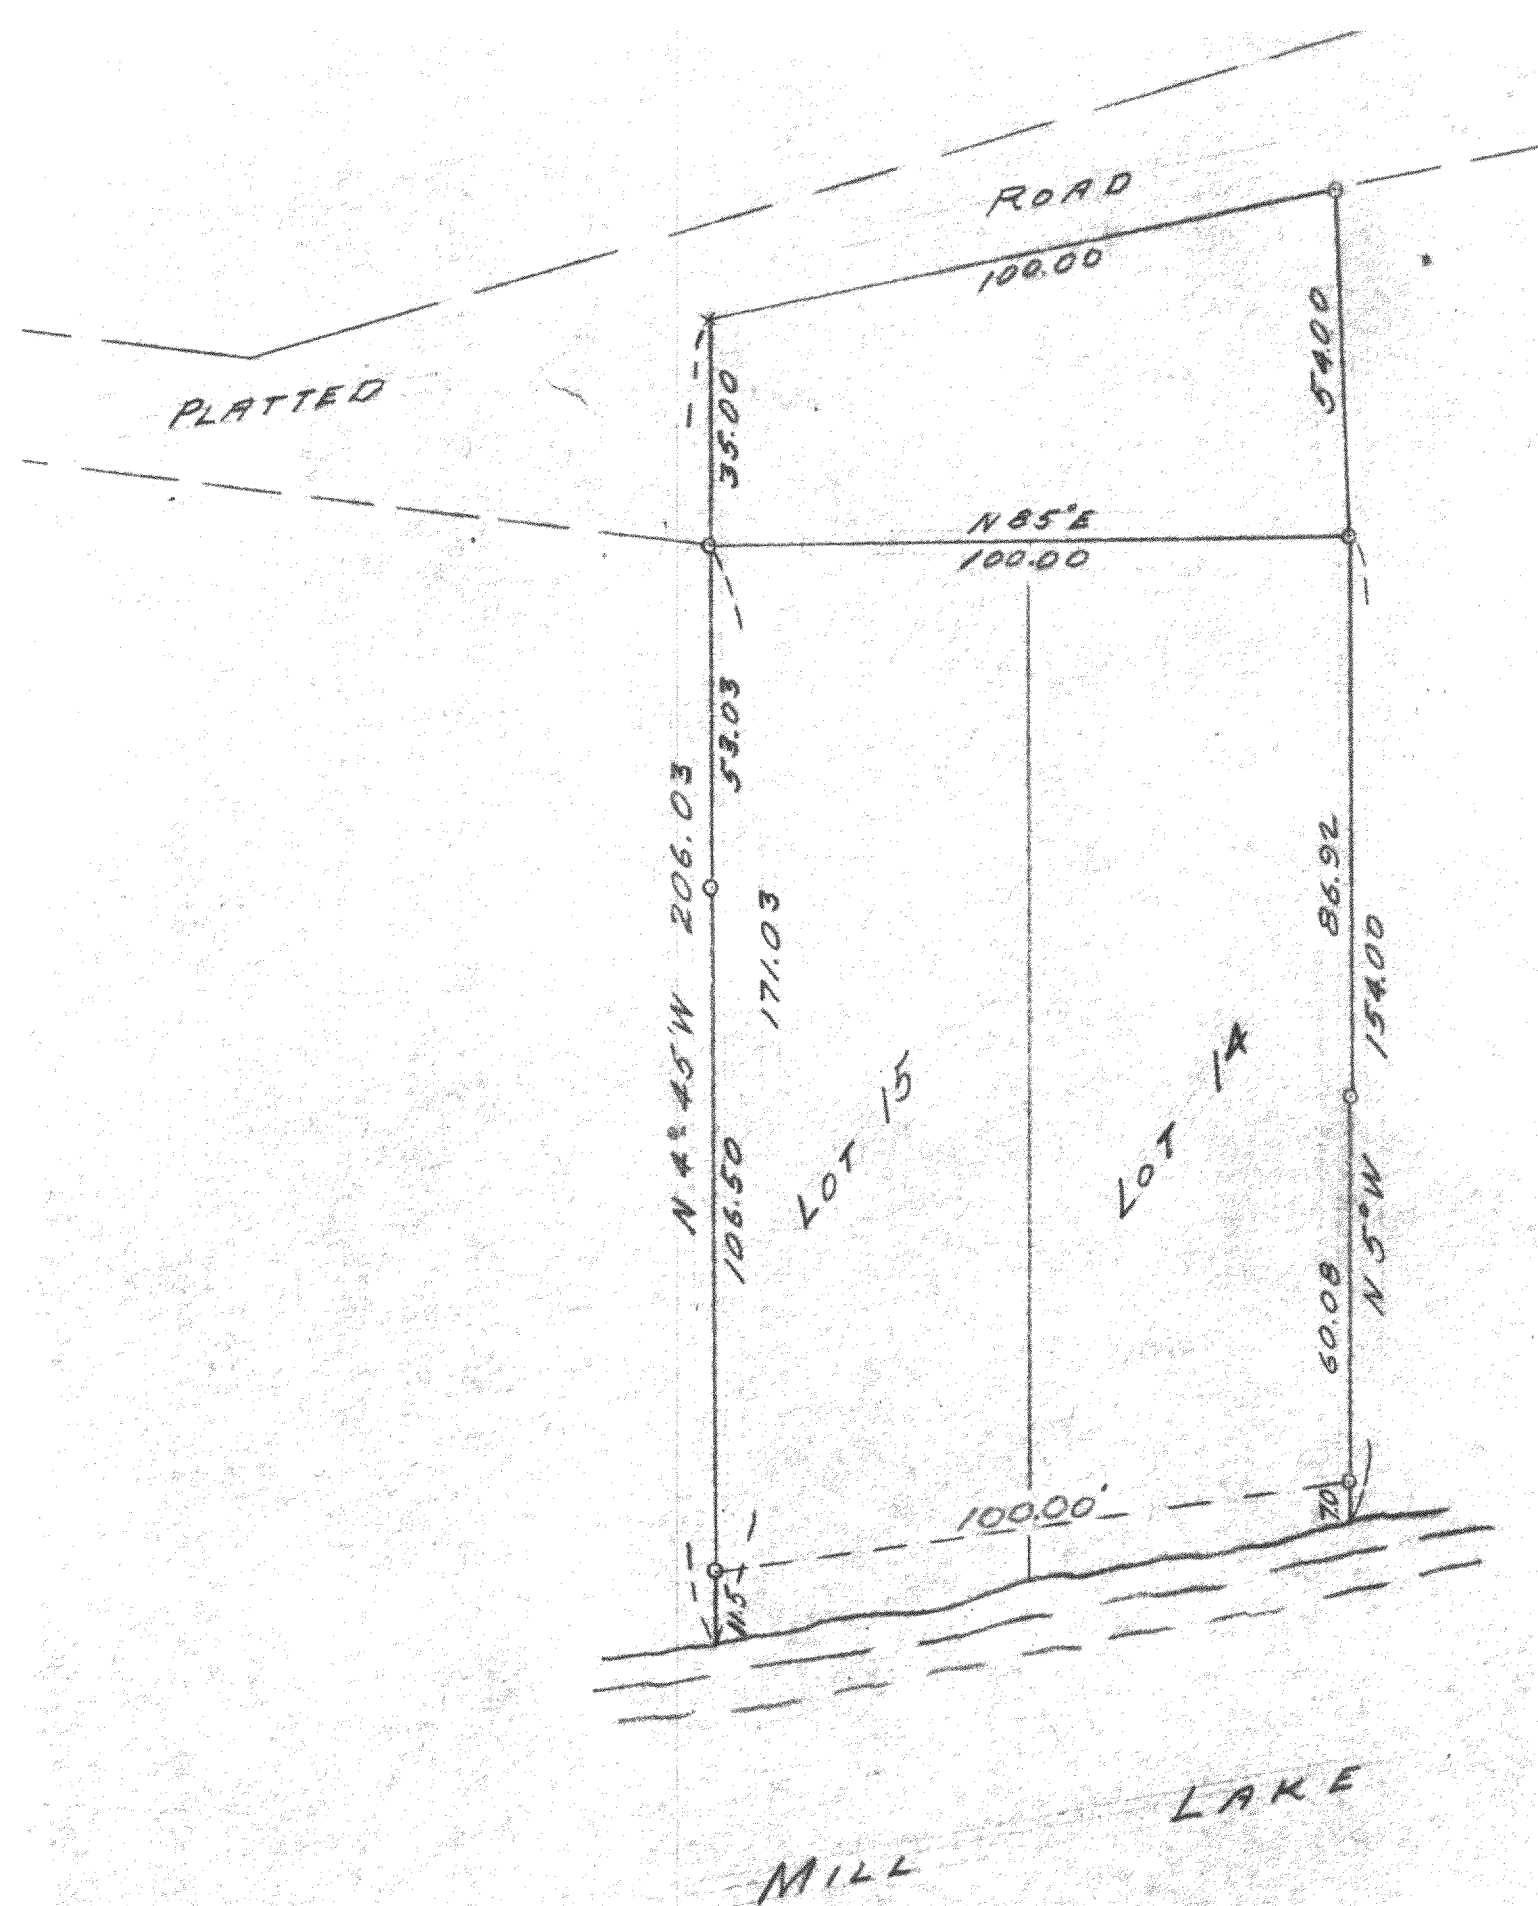

- o = IRON PIPE
x = SPIKE IN EXISTING ROADWAY

PLAT OF SURVEY
OF
LOT 14 AND LOT 15
BLOCK 3 CARSWELLS PARK
AND
ADJOINING PARCEL
WALWORTH CO, WISCONSIN

Lloyd L. Jensen
SURVEYOR

SCALE 1" = 30'

DATE JUNE 1953

HCA-35

A16-78.1