


●-INDICATES IRON PIPE FOUND
○-INDICATES IRON PIPE SET

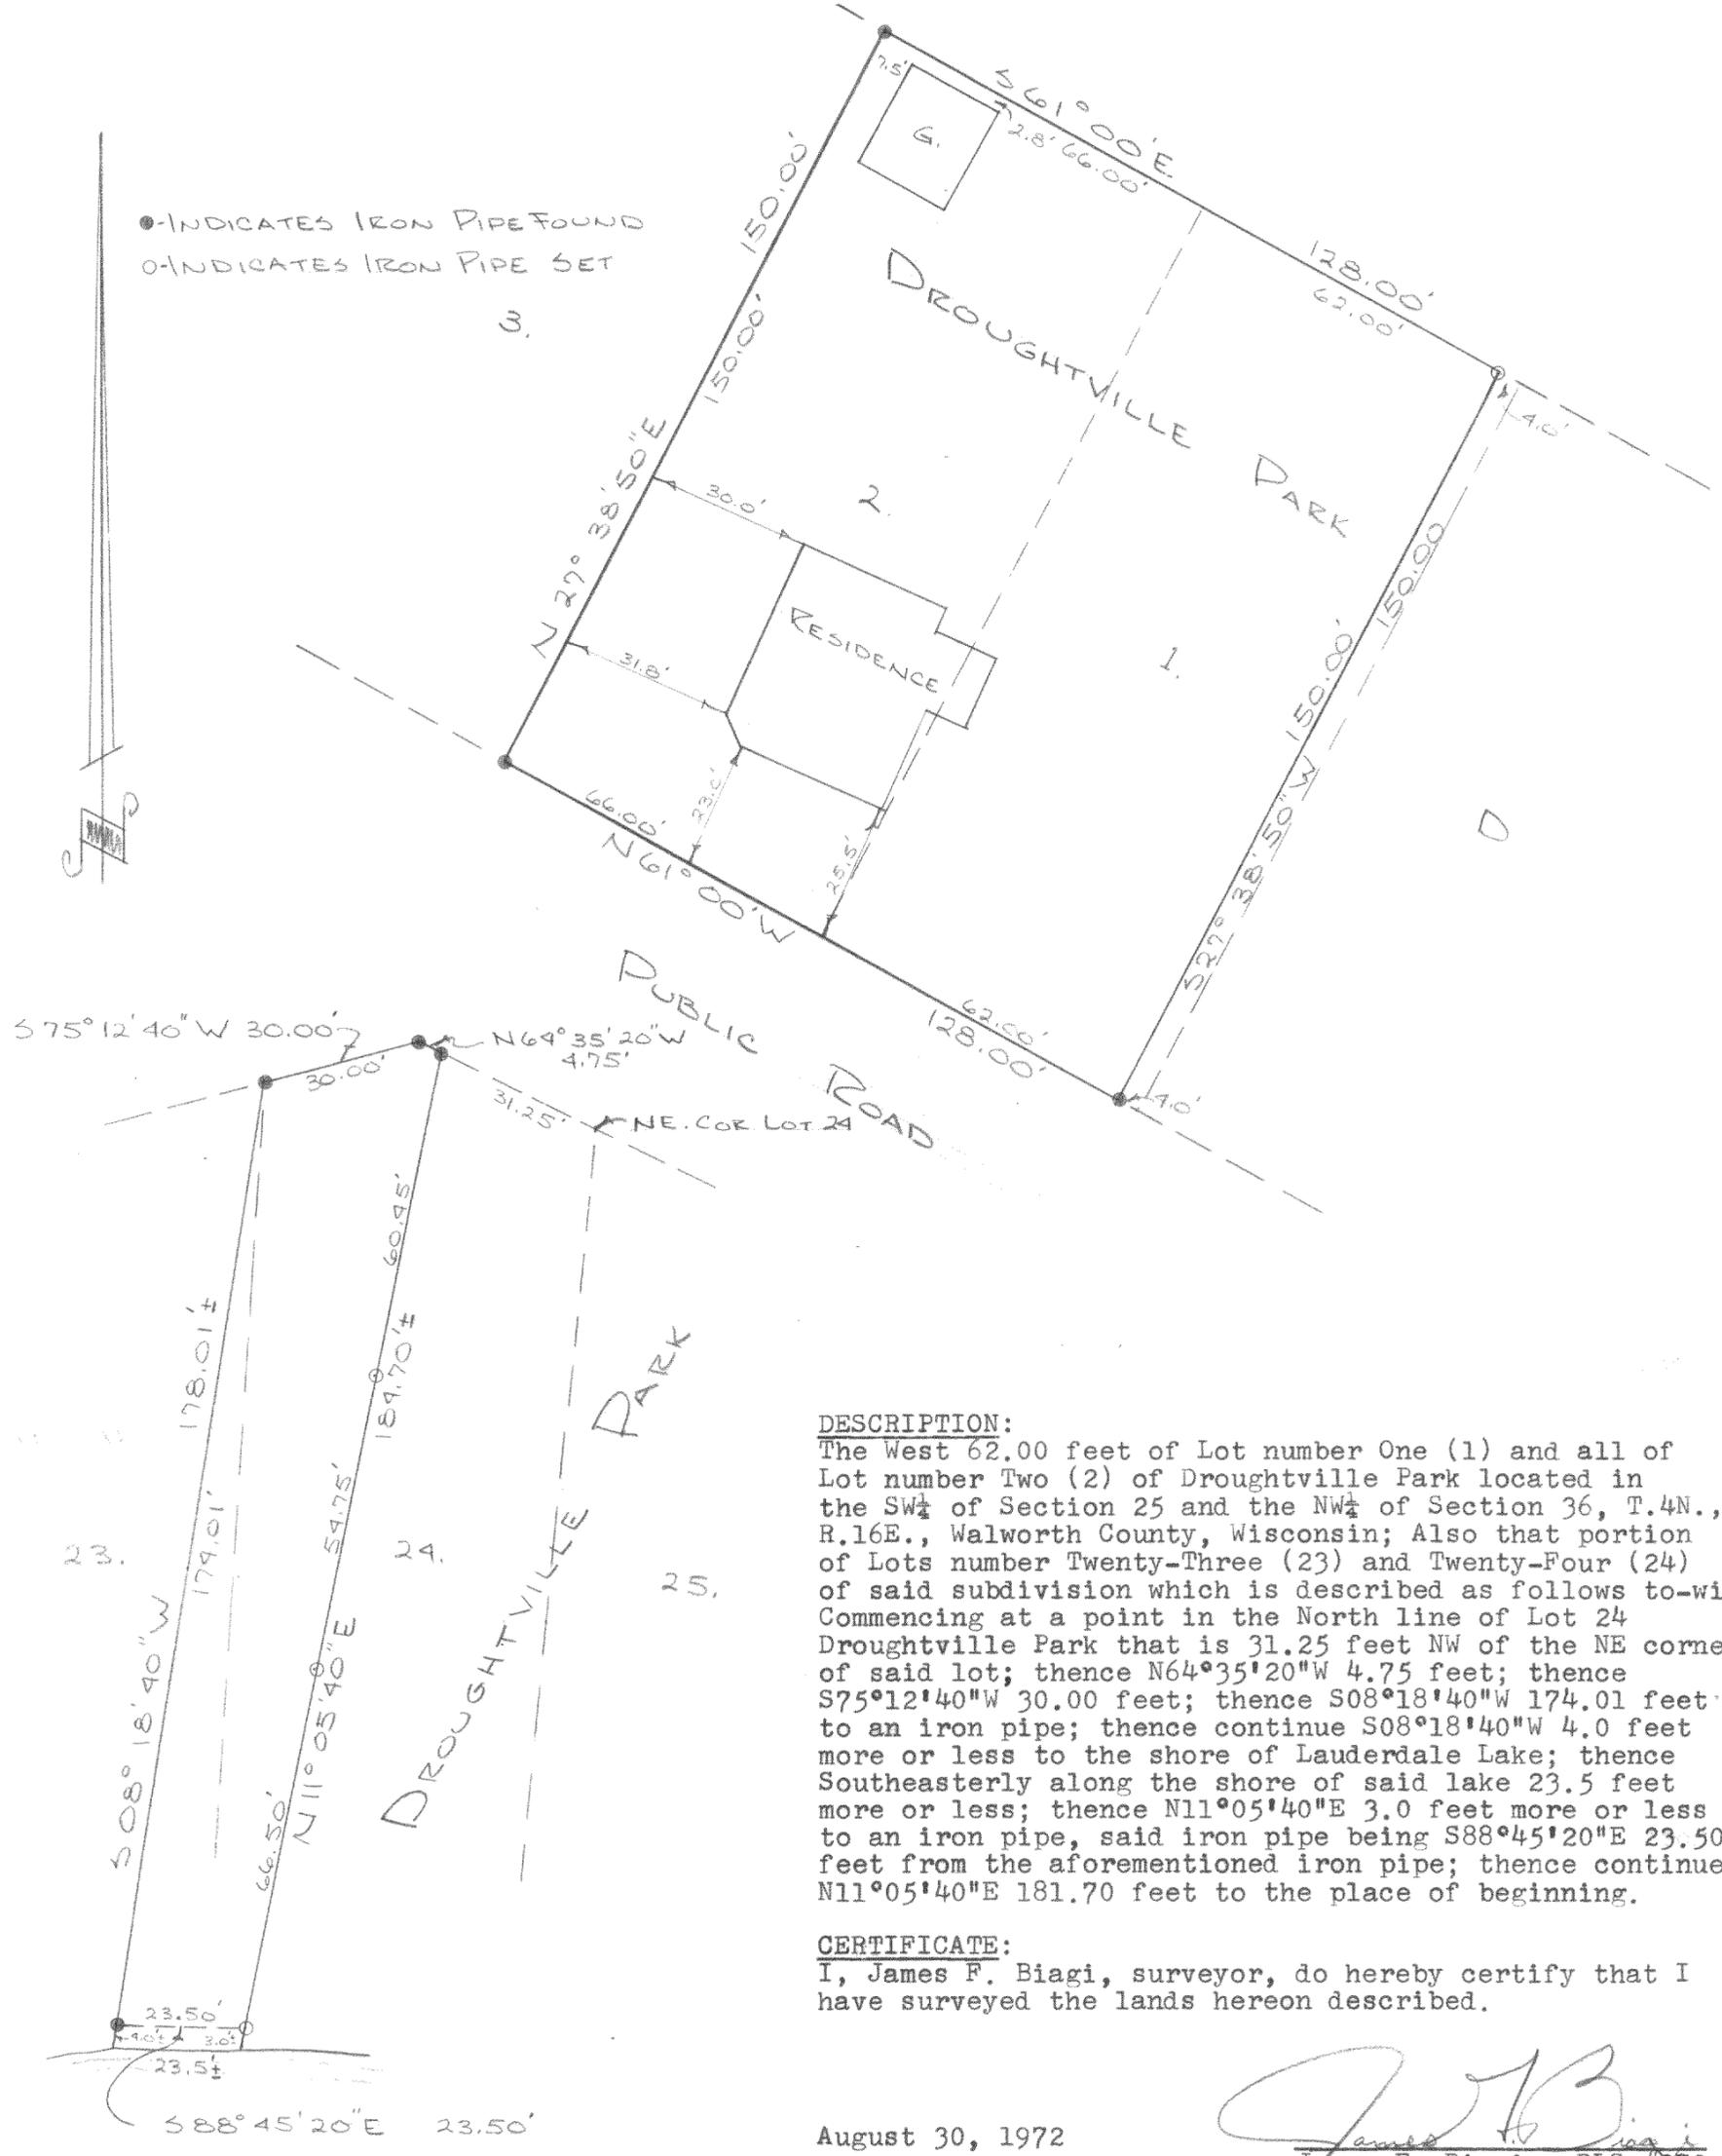

DESCRIPTION:

The West 62.00 feet of Lot number One (1) and all of Lot number Two (2) of Droughtville Park located in the SW $\frac{1}{4}$ of Section 25 and the NW $\frac{1}{4}$ of Section 36, T.4N., R.16E., Walworth County, Wisconsin; Also that portion of Lots number Twenty-Three (23) and Twenty-Four (24) of said subdivision which is described as follows to-wit: Commencing at a point in the North line of Lot 24 Droughtville Park that is 31.25 feet NW of the NE corner of said lot; thence N64°35'20"W 4.75 feet; thence S75°12'40"W 30.00 feet; thence S08°18'40"W 174.01 feet to an iron pipe; thence continue S08°18'40"W 4.0 feet more or less to the shore of Lauderdale Lake; thence Southeasterly along the shore of said lake 23.5 feet more or less; thence N11°05'40"E 3.0 feet more or less to an iron pipe, said iron pipe being S88°45'20"E 23.50 feet from the aforementioned iron pipe; thence continue N11°05'40"E 181.70 feet to the place of beginning.

CERTIFICATE:

I, James F. Biagi, surveyor, do hereby certify that I have surveyed the lands hereon described.

August 30, 1972

James F. Biagi
 James F. Biagi RLS #272



LAUDERDALE LAKE

HDP-11.424A