


WALWORTH COUNTY SURVEYING & MAPPING

727 HENRY STREET
LAKE GENEVA, WISCONSIN
414-248-0505


MIDDLE LAKE

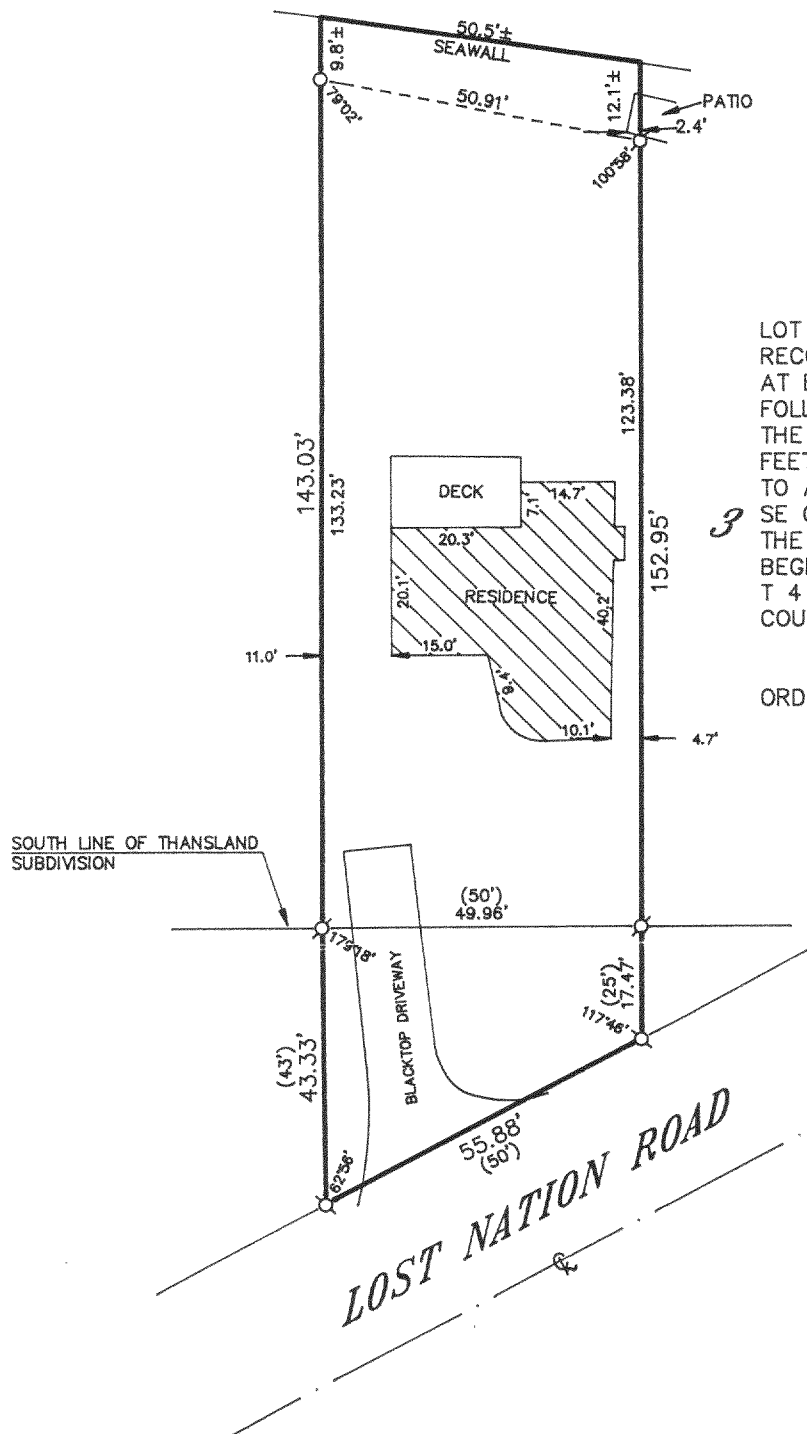

PLAT OF SURVEY OF

LOT 4 IN BLOCK 2 THANSLAND AS PLATTED AND
RECORDED IN THE REGISTER OF DEEDS OFFICE
AT ELKHORN, WISCONSIN. TOGETHER WITH THE
FOLLOWING PARCEL OF LAND: COMMENCING AT
THE SW CORNER OF SAID LOT, THENCE S'LY 43
FEET TO AN IRON STAKE; THENCE NE'LY 50 FEET
TO AN IRON STAKE; THENCE N'LY 25 FEET TO THE
SE CORNER OF ABOVE LOT NO. 4; THENCE ALONG
THE S. LINE OF SAID LOT W'LY TO THE PLACE OF
BEGINNING. ALL BEING A PORTION OF SEC. 35,
T 4 N, R 16 E, TOWN OF LAGRANGE, WALWORTH
COUNTY, WISCONSIN.

ORDERED BY: KEEFE REAL ESTATE
704 MAIN STREET
LAKE GENEVA, WISCONSIN
53147

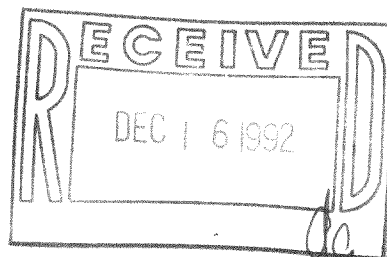

I HEREBY CERTIFY THAT I HAVE SURVEYED THE ABOVE DESCRIBED
PROPERTY AND THAT THE ABOVE MAP IS A TRUE REPRESENTATION
THEREOF AND SHOWS THE SIZE AND LOCATION OF THE PROPERTY,
ITS EXTERIOR BOUNDARIES, THE LOCATION OF ALL VISIBLE STRUCTURES
AND DIMENSIONS OF ALL PRINCIPAL BUILDINGS THEREON, BOUNDARY
FENCES, APPARENT EASEMENTS, ROADWAYS AND VISIBLE ENCROACH-
MENTS, IF ANY, TO THE BEST OF MY KNOWLEDGE AND BELIEF.

THIS SURVEY IS MADE FOR THE USE OF THE PRESENT OWNERS OF
THE PROPERTY AND ALSO THOSE WHO PURCHASE, MORTGAGE OR
GUARANTEE THE TITLE THERETO WITHIN ONE (1) YEAR FROM DATE
HEREOF.

Robert M. Baerenwald
ROBERT M. BAERENWALD
WISCONSIN REGISTERED LAND SURVEYOR, S-1508

DATE *July 28, 1992* JOB NO. 3495

NOTE: THIS IS NOT A CERTIFIED COPY UNLESS SEALED.

