
KOLB LAND CONSULTING, INC.

LAND SURVEYING . SUBDIVIDING . LAND PLANNING

929 WILLIAMS STREET

LAKE GENEVA, WISCONSIN 53147

414-248-3697

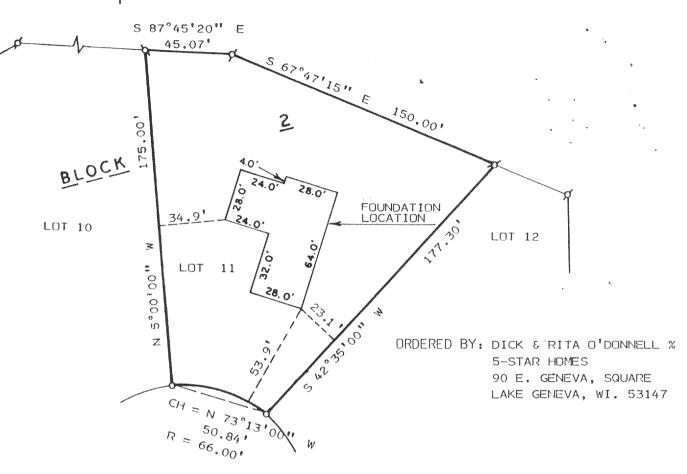



SCALE: 1" = 50'

LEGEND

p - IRON PIPE FOUND
o - IRON PIPE SET

PLAT OF SURVEY OF

LOT 11, BLOCK 2 OF PEBBLE BEACH A SUBDIVISION LOCATED IN SECTIONS 25 AND 26, T4N, R16E, TOWN OF LAGRANGE, WALWORTH COUNTY, WISCONSIN.



I, HAROLD H. KOLB, DO HEREBY CERTIFY THAT I HAVE SURVEYED THE PROPERTY HEREON DESCRIBED ACCORDING TO THE OFFICIAL RECORDS AND THAT THE PLAT HEREON IS A CORRECT REPRESENTATION OF THE LOT LINES TO THE BEST OF MY KNOWLEDGE AND BELIEF.
SURVEY NOT VALID UNLESS SURVEYOR'S SIGNATURE IS IN RED.

HAROLD H. KOLB

WISCONSIN REGISTERED LAND SURVEYOR, S-187

DATE DECEMBER 11, 1991
REVISED JANUARY 22, 1992

416-908

REVISED APRIL 15, 1992

HPE-34


KOLB LAND CONSULTING, INC.

LAND SURVEYING . SUBDIVIDING . LAND PLANNING

929 WILLIAMS STREET

LAKE GENEVA, WISCONSIN 53147

414-248-3697

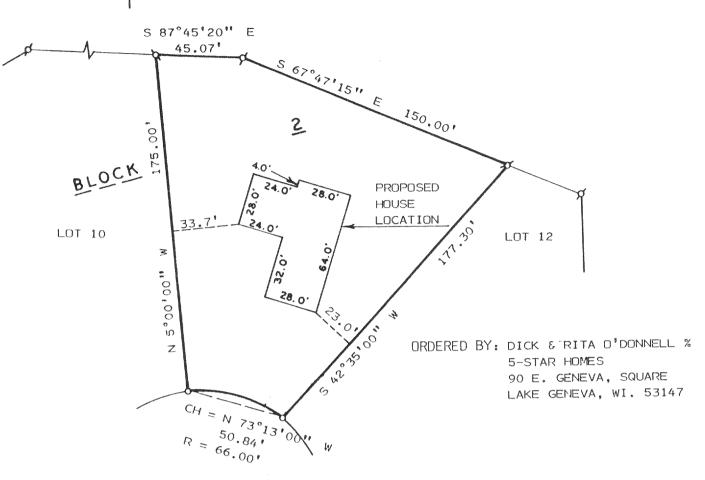



SCALE: 1" = 50'

LEGEND

Ø- IRON PIPE FOUND

o - IRON PIPE SET

PLAT OF SURVEY OF

LOT 11, BLOCK 2 OF PEBBLE BEACH A SUBDIVISION LOCATED IN SECTIONS 25 AND 26, T4N, R16E, TOWN OF LAGRANGE, WALWORTH COUNTY, WISCONSIN.



I, HAROLD H. KOLB, DO HEREBY CERTIFY THAT I HAVE SURVEYED THE PROPERTY HEREON DESCRIBED ACCORDING TO THE OFFICIAL RECORDS AND THAT THE PLAT HEREON IS A CORRECT REPRESENTATION OF THE LOT LINES TO THE BEST OF MY KNOWLEDGE AND BELIEF.
SURVEY NOT VALID UNLESS SURVEYOR'S SIGNATURE IS IN RED.

HAROLD H. KOLB

WISCONSIN REGISTERED LAND SURVEYOR, S-187

DATE DECEMBER 11, 1991

REVISED JANUARY 22, 1992

REVISED_

416-908

HPE - 34